

FEB 24 2000

OTTAWA COUNTY REMONUMENTATION  
LAND CORNER RECORDATION CERTIFICATE  
Filing Requirement of Act 74, Mich. P.A. 1970

RECORDED  
99 SEP 23 PM 3: 21

For corners in SECTION

OTTAWA  
(County)

Located In: ZEELAND TOWNSHIP  
Corner Code #

- 1. Public Land Survey T 5N R 14W E-1  
T R NW Corner  
T R Section 4  
T R
- 2. Property Controlling in Section S T R
- 3. Miscellaneous S T R  
Property In Sec. S T R


*Sam Johnston*  
REGISTER OF DEEDS  
OTTAWA COUNTY, MI

Register of Deeds Stamp & File Number

- 4. Lot No. \_\_\_\_\_, Recorded Plat \_\_\_\_\_
- 5. Private Claims \_\_\_\_\_

I, Rodney D. Unema, in a field survey on September 16, 1999 do hereby state that under requirements of P.A. 74, Michigan P.A. of 1970, the corner points mentioned in lines 1 and 2 above were in conformance with regulations and rules therefore as required in the current manual of survey instructions of the United States Department of the Interior, Bureau of Land Management or by a decree of a Court of Law and /or that the corner points mentioned in lines 3, 4 and 5 above were in conformance with the rules of the Michigan Board of Land Surveyors or by a Decree of a Court of Law; established, re-established, monumented, recovered, found as expressed below:

**NOTE: Not more than 2 corners, all in the same town and range, may be recorded on this certificate.**

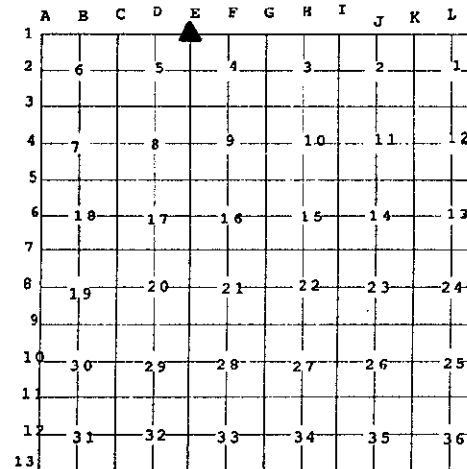

A. Description of original monument and accessories and/or subsequent restoration:

E-1 NW Corner, Section 4

March 31, 1832, G.L.O. Survey by C. Britain	August 11, 1976 (Clapp)
Set corner to Sections 4 & 5	Liber 3, page 103
73 Links West of Post	Found Stone, Set Cast Iron Mon. over Stone
7" Sugar S69°E 25 links	Street Sign SE 37.2'
7" Beech S36°W 16 links	12" Basswood WSW 57.95'
	20" Basswood NE 104.61'
	Blendon Corner E 47.22'

B. Description of corner evidence found and/or method applied in restoring or reestablishing corner:


E-1 Found Cast Iron Monument in Gravel Road (15' down)

Found E-13 T6N, R14W, Cast iron mon.	East	47.23'	*OVER FOR SKETCH
Centerline street sign	SE	48.0'	
Centerline of 20" Ash	S70°W	57.8'	
Centerline of gravel road to South	West	2'	

Measured existing cast iron monument to be 1.27' North of Township line; and accepted as a careful and faithful perpetuation of the position of the original corner. Set Ottawa County Cap on 3/4" x 24" bar on Township line, 1.27' South of existing cast iron monument.

C. Description of monument for corner and accessories established to perpetuate locating the position of the corner:

E-1 Ottawa County Cap & Bar in Gravel Road (New Holland) 4" down		
Set nail & O.C. remon tag in N. sde 20" Ash	S70°W	57.32'
Set nail & O.C. remon tag in SW sde P. Pole	S62°E	118.62'
Centerline of SW metal guard post (5" dia) by gas valve	N51°E	105.36'
Set rod 0.5' West of West post of street sign	N8°W	19.47'
Cast iron monument (closing corner)	North	1.27'
E-13 T6N, R14W	East	47.23'
Centerline of E-W gravel road	North	2.5'
Centerline of gravel road to South	West	2'

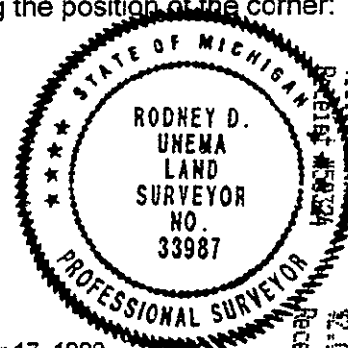

Signed by Rodney D. Unema  
Surveyor's Michigan License No. 33987

Date September 17, 1999

FEB 24 2000

SECTION

