

**SURVEY &
REMONUMENTATION**

APR 05 1996

**Ottawa County Remonumentation
LAND CORNER RECORDATION CERTIFICATE
Filing Requirement of Act 74, Mich. P.A. 1970**

For corners in **COMMISSION**

<u>Ottawa</u> (County)	Located In:	Corner Code #
1. Public Land Survey	T <u>5N</u> R <u>14W</u>	<u>E-6 (E$\frac{1}{2}$, 17)</u>
	T _____ R _____	<u>Zeeland Twp.</u>
	T _____ R _____	_____
	T _____ R _____	_____
2. Property Controlling in Section	S _____ T _____ R _____	_____
	S _____ T _____ R _____	_____
3. Miscellaneous Property in Sec.	S _____ T _____ R _____	_____
	S _____ T _____ R _____	_____
4. Lot No. _____, Recorded Plat _____		
5. Private Claims _____		


RECORDED

95 NOV 29 PM 1:45

Robert C. Williams
REGISTER OF DEEDS
OTTAWA COUNTY, MI

Register of Deeds Stamp & File Number

I, John C. Bueche, in a field survey on November 10, 19 95, do hereby certify that under requirements of P.A. 74, Michigan P.A. of 1970, the corner points mentioned in lines 1 and 2 above were in conformance with regulations and rules therefore as required in the current manual of survey instructions of the United States Department of the Interior, Bureau of Land Management or by a decree of a Court of Law and/or that the corner points mentioned in lines 3, 4 and 5 above were in conformance with the rules of the Michigan Board of Land Surveyors or by a Decree of a Court of Law; established, re-established, monumented, re-monumented, recovered, found as expressed below:

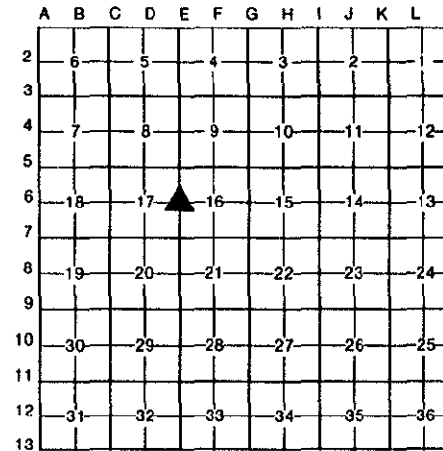

NOTE: Not more than 4 corners, all in the same town and range, may be recorded on this certificate.

A. Description of original monument and accessories and/or subsequent restoration:

E-6 GLO Calvin Britain, D.S.	LCRC L2-P375, 1973 3/4" pipe	LCRC L4-P42, March, 1980 Found 3/4" pipe, set 1/2" rod on top
Set 1/2 mile post	TP S 20 E 15.39' PP N 50 W 79.50'	PP N 50 W 79.96'
Sugar 10 N 58 E 31	TP N 40 W 42.15'	C/L Tel. ped. S 40 W 44.60'
Sugar 10 N 84 W 16		C/L st. sign N 50 W 39.56'
		PP N 75 E 195.28'
		OVER

B. Description of corner evidence found and/or method applied in restoring or reestablishing corner:

E-6 Found cast iron mon. in Mon. Box
PP NW 79.98'
C/L st. sign NW 39.6'
C/L Tel. ped. SW 44.6'

And is accepted as a careful and faithful perpetuation of the position of the original corner.

PEER APPROVED 11-20-95


Robert C. Williams
J.C.B.

C. Description of monument for corner and accessories established to perpetuate locating the position of the corner:

E-6 Cast iron mon. in Mon. Box
Set Nail & Ottawa Co. Remon. Tag in SW side PP S 45 W 79.95'
Top C/L Tel. ped. S 45 W 44.27'
SW cor. hse. fnd. N 20 E 244.50'
Set Nail & Ottawa Co. Remon. Tag in E side 24" Maple N 10 W 147.73'
Set Nail & Ottawa Co. Remon. Tag in NE side PP N 80 E 195.36'
C/L bit. N, 2'± East
C/L bit. E-W, 1'± South

Signed by John C. Bueche
John C. Bueche, P.S. 13027
Surveyor's Michigan License No. _____

Date Nov 16, 1995

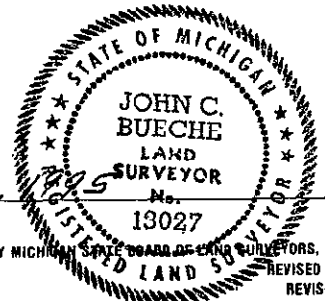

FORM APPROVED BY MICHIGAN STATE BOARD OF LAND SURVEYORS, JAN. 28, 1988
REVISED MAY 14, 1990
REVISED JAN., 1995

LCRC L4-P53, May, 1980

Cast iron mon.

PP	NW	79.98'
C/L st. sign	NW	39.6'
C/L Tel. ped.	SW	44.6'
C/L warning sign	S	32.5'
C/L gas line marker	NE	42.4'

\$ 11.00 CORNER