

**SURVEY & REMONUMENTATION**

APR 25 1995

COMMISSION

Ottawa County Remonumentation  
**LAND CORNER RECORDATION CERTIFICATE**  
 Filing Requirement of Act 74, Mich. P.A. 1970

RECORDED

94 DEC -8 PM 12:37

*Polypolis Robinson*  
 REGISTER OF DEEDS  
 OTTAWA COUNTY, MI

or corners in  
Ottawa

(County)

Located In: Corner Code #

Public Land Survey	T	5N	R	14W	E-7 (SE, 17)
	T		R		Zeeland Twp.
	T		R		
	T		R		
Property Controlling in Section	S		T	R	
Miscellaneous	S		T	R	
Property in Sec.	S		T	R	

Register of Deeds Stamp & File Number

Lot No. \_\_\_\_\_, Recorded Plat \_\_\_\_\_  
 Private Claims \_\_\_\_\_

	A	B	C	D	E	F	G	H	I	J	K	L	M
2	6	5	4	3	2	1							
3													
4	7	8	9	10	11	12							
5													
6	18	17	16	15	14	13							
7													
8	19	20	21	22	23	24							
9													
10	30	29	28	27	26	25							
11													
12	31	32	33	34	35	36							
13													

John C. Bueche, in a field survey on October 18, 1994, hereby certify that under requirements of P.A. 74, Michigan P.A. of 1970, the corner points mentioned in lines 1 and 2 above were in conformance with regulations and rules therefore as required in the current manual of survey instructions of the United States Department of the Interior, Bureau of Land Management or by a decree of a Court of Law and/or that the corner points mentioned in lines 3, 4 and 5 above were in conformance with the rules of the Michigan Board of Land Surveyors or by a Decree of a Court of Law; established, re-established, monumented, re-monumented, recovered, found as expressed below:

**OTE: Not more than 4 corners, all in the same town and range, may be recorded on this certificate.**

Description of original monument and accessories and/or subsequent restoration:

E-7 GLO March, 1832	LCRC L5-P298	LCRC L5-P292
Calvin Britain, D.S.	3/4" iron in Mon. Box,	Iron in Mon. Box,
Set cor.	March, 1988	March, 1988
Sugar 7 N 29 W 18	N face gutter pan S 11.74'	No wit.
Beech 10 S 17 E 14	N edge conc. pav't. N 12.31'	
	NW cor. CB ESE 147.10'	
	Most E'ly reflector	
	post WSW 48.14'	

Description of corner evidence found and/or method applied in restoring or reestablishing corner:


E-7 Found iron in Mon. Box  
 As per above wit.

And is accepted as a careful and faithful perpetuation of the position of the original corner.

PR. 040 OTTAWA COUNTY

PEER APPROVED 11/21/94

*Madon P. Nedema*

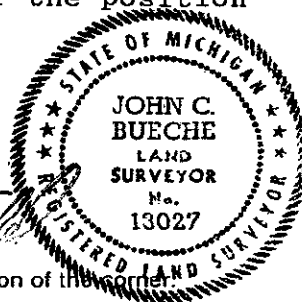

Description of monument for corner and accessories established to perpetuate locating the position of the corner:

E-7 Replaced iron with Ottawa Co. Mon. (3/4" x 24" Pin with Alum. Cap)	
PK Nail & Ottawa Co. Remon. Tag in bit. in conc. island S 63 E 35.91'	
PK Nail & Ottawa Co. Remon. Tag in bit. in conc. island S 63 W 36.20'	
Face conc. curb	S 00 E 13.35'
N edge conc. rd.	N 00 E 12.33'
On C/L rd. of W.B.L.	
E edge conc. overpass for I-196	W 200'±
C/L joint of conc.	N 0.40'±

Signed by John C. Bueche  
 Surveyor's Michigan License No. 13027

Date 11-18-94