

# SURVEY & REMONUMENTATION

APR 25 1995

COMMISSION

Ottawa County Remonumentation  
LAND CORNER RECORDATION CERTIFICATE  
Filing Requirement of Act 74, Mich. P.A. 1970

RECORDED

DEC -8 PM 12:37

or corners in

Ottawa (County)	Located In:	Corner Code #
Public Land Survey	T <u>5N</u> R <u>14W</u>	<u>E-8 (E<math>\frac{1}{2}</math>, 20)</u> <u>Zeeland Twp.</u>
	T _____ R _____	_____
	T _____ R _____	_____
	T _____ R _____	_____
Property Controlling in Section	S _____ T _____ R _____	_____
	S _____ T _____ R _____	_____
Miscellaneous Property in Sec.	S _____ T _____ R _____	_____
	S _____ T _____ R _____	_____

*Richard R. Williams*  
REGISTER OF DEEDS  
OTTAWA COUNTY, MI

Register of Deeds Stamp & File Number

Lot No. \_\_\_\_\_, Recorded Plat \_\_\_\_\_  
Private Claims \_\_\_\_\_

	A	B	C	D	E	F	G	H	I	J	K	L	M
2	6		5		4		3		2		1		
3													
4	7		8		9		10		11		12		
5													
6	18		17		16		15		14		13		
7													
8	19		20		21		22		23		24		
9													
10	30		29		28		27		26		25		
11													
12	31		32		33		34		35		36		
13													

John C. Bueche in a field survey on November 18, 19 94  
I hereby certify that under requirements of P.A. 74, Michigan P.A. of 1970, the corner points mentioned in lines 1 and 2 above were in conformance with regulations and rules therefore as required in the current manual of survey instructions of the United States Department of the Interior, Bureau of Land Management or by a decree of a Court of Law and/or that the corner points mentioned in lines 3, 4 and 5 above were in conformance with the rules of the Michigan Board of Land Surveyors or by a Decree of a Court of Law; established, re-established, monumented, re-monumented, recovered, found as expressed below:

**NOTE: Not more than 4 corners, all in the same town and range, may be recorded on this certificate.**

Description of original monument and accessories and/or subsequent restoration:

E-8 GLO March, 1832	LCRC L5-P292
Calvin Britain, D.S.	T fe. post, March, 1988
Set post	Fe. lines N, E & W
Black Ash 20 N 27 E 30	14" Maple NNW 174.50'
Maple 10 S 36 W 46	10" Ash W 106.16'
	14" Elm SW 101.17'
	10" Oak SSW 130.83'


Description of corner evidence found and/or method applied in restoring or reestablishing corner:

E-8 Found T fe. post down 1.5'± in muck field  
As per above wit.

And is accepted as a careful and faithful perpetuation of the position of the original corner.

P.A. 345 OTTAWA COUNTY  
PEER APPROVED 11/21/94

*Richard R. Williams*

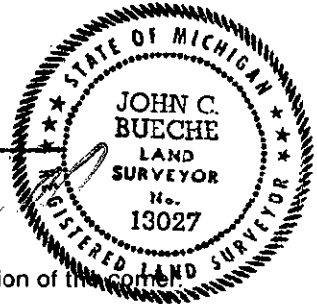

Description of monument for corner and accessories established to perpetuate locating the position of the corner:

E-8 Placed Ottawa Co. Mon. (3/4" x 24" Pin & Alum. Cap) on top of existing T fe. post

Nail & Ottawa Co. Remon. Tag in W side	16" Oak	S 38 W 130.50'
Nail & Ottawa Co. Remon. Tag in S side	12" Oak	S 58 W 94.12'
Nail & Ottawa Co. Remon. Tag in N side	16" Oak	N 90 W 90.61'
Nail & Ottawa Co. Remon. Tag in N side	16" Oak	N 53 W 103.88'
Nail & Ottawa Co. Remon. Tag in E side	12" W. Cherry	N 14 W 127.10'
E edge woods		W 90'±
C/L ditch E-W		N 8'±
C/L river N-S		E 400'±

Signed by John C. Bueche Date 11-18-94  
Surveyor's Michigan License No. 13027