

**SURVEY &
REMONUMENTATION**

APR 05 1996

Ottawa County Remonumentation
LAND CORNER RECORDATION CERTIFICATE
Filing Requirement of Act 74, Mich. P.A. 1970

For corners in **COMMISSION**

<u>Ottawa</u> (County)	Located In:	Corner Code #
1. Public Land Survey	T <u>5N</u> R <u>14W</u>	E-13 (SE, 32) <u>Zeeland Twp.</u>
	T _____ R _____	_____
	T _____ R _____	_____
	T _____ R _____	_____
2. Property Controlling in Section	S _____ T _____ R _____	_____
	S _____ T _____ R _____	_____
3. Miscellaneous Property in Sec.	S _____ T _____ R _____	_____
	S _____ T _____ R _____	_____
4. Lot No. _____, Recorded Plat _____		
5. Private Claims _____		

RECORDED
95 NOV 29 PM 1:45
D. P. Redwood
REGISTER OF DEEDS
OTTAWA COUNTY, MI
Register of Deeds Stamp & File Number

I, John C. Bueche, in a field survey on November 17, 19 95, do hereby certify that under requirements of P.A. 74, Michigan P.A. of 1970, the corner points mentioned in lines 1 and 2 above were in conformance with regulations and rules therefore as required in the current manual of survey instructions of the United States Department of the Interior, Bureau of Land Management or by a decree of a Court of Law and/or that the corner points mentioned in lines 3, 4 and 5 above were in conformance with the rules of the Michigan Board of Land Surveyors or by a Decree of a Court of Law; established, re-established, monumented, re-monumented, recovered, found as expressed below:

A	B	C	D	E	F	G	H	I	J	K	L	M
2	6	5	4	3	2	1						
3												
4	7	8	9	10	11	12						
5												
6	18	17	16	15	14	13						
7												
8	19	20	21	22	23	24						
9												
10	30	29	28	27	26	25						
11												
12	31	32	33	34	35	36						
13												

NOTE: Not more than 4 corners, all in the same town and range, may be recorded on this certificate.

A. Description of original monument and accessories and/or subsequent restoration:

E-13 GLO	LCRC L1-P55, 1971	LCRC L3-P230, 1977
Lucius Lyon, Iron pipe with hexagon	D.S., 1832 nut	Set cast iron mon.
Set post cor. Nail in face 8" Ash	Sec. 32-33 NW 103.68'	"T" iron NW 46.7
Hemlock 4 Nail in face 20" Stump	N 72 E 30 NW 48.81'	C/L warning sign SW 14.8
Beech 14 Nail in face 8" Poplar	N 74 W 25 SW 25.28'	Nail & Tag 18435 face 6" Ash SE 52.0
		Nail & Tag 18435 face 8" Ash SW 34.7
		Nail & Tag 18435 face 6" Ash NW 51.6
		Nail & Tag 18435 face 12" Ash NW 103.5

B. Description of corner evidence found and/or method applied in restoring or reestablishing corner:

E-13 Found cast iron mon. in gravel rd. down .9' **PEER APPROVED 11-20-95**
Nail & Tag 18435 face 6" Ash SE 52.04'
Nail & Tag 18435 face 8" Ash SW 34.76'
1/2" rebar W 47.52'

P.A. 345 OTTAWA COUNTY
Redwood


And is accepted as a careful and faithful perpetuation of the position of the original corner.

C. Description of monument for corner and accessories established to perpetuate locating the position of the corner:

E-13 Cast iron mon. in gravel rd.
Existing 40d Nail & Tag in SE side dbl. 14" Ash S 65 W 34.82'
Existing 40d Nail & Tag in NE side 8" Ash N 45 W 79.27'
Nail & Ottawa Co. Remon. Tag in SW side dbl. 12" Ash S 50 E 65.58'
Top C/L hydt. N 30 E 54.53'
On C/L bit. N, C/L gravel E-W, North 6'±

Signed by John C. Bueche
John C. Bueche, P.S. 13027
Surveyor's Michigan License No. _____

Date Nov 19, 1995

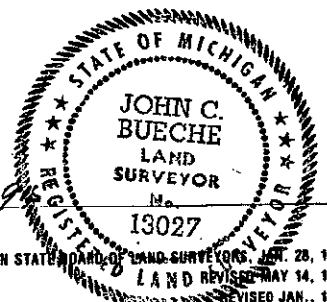

FORM APPROVED BY MICHIGAN STATE BOARD OF LAND SURVEYORS, JAN. 28, 1971; REVISED MAY 14, 1971; REVISED JAN., 1981.

LCRC L5-P293, 1988
Cast iron mon.
Same wit. as L3-P230
1/2" steel bar NW cor.
Sec. 4, 4-14, West 47.52'

\$ 11.00 CORNER