

# SURVEY & REMONUMENTATION

APR 25 1995

COMMISSION

Ottawa County Remonumentation  
**LAND CORNER RECORDATION CERTIFICATE**  
 Filing Requirement of Act 74, Mich. P.A. 1970

RECORDED

94 DEC -8 PM 12:38


*Phyllis Robinson*  
 REGISTER OF DEEDS  
 OTTAWA COUNTY, MI

corners in  
Ottawa  
 (County)

Located In:	Corner Code #
T 5N R 14W	F-3 (S $\frac{1}{2}$ , 4)
T _____ R _____	Zeeland Twp.
T _____ R _____	_____
T _____ R _____	_____
T _____ R _____	_____
Property Controlling in Section S _____ T _____ R _____	_____
Miscellaneous S _____ T _____ R _____	_____
Property in Sec. S _____ T _____ R _____	_____

Register of Deeds Stamp & File Number

Lot No. \_\_\_\_\_, Recorded Plat \_\_\_\_\_  
 Private Claims \_\_\_\_\_

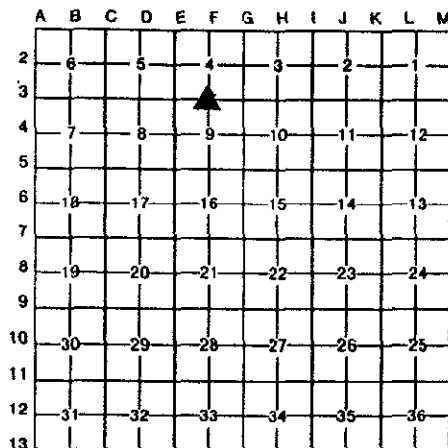

John C. Bueche, in a field survey on October 25, 19 94, hereby certify that under requirements of P.A. 74, Michigan P.A. of 1970, the corner points mentioned in lines 1 and 2 above were in conformance with regulations and rules therefore as required in the present manual of survey instructions of the United States Department of the Interior, Bureau of Land Management or by a decree of a Court of Law and/or that the corner points mentioned in lines 3, 4 and 5 above were in conformance with the rules of the Michigan Board of Land Surveyors or by a Decree of a Court of Law; established, re-established, monumented, re-monumented, recovered, found as recorded below:

**NOTE: Not more than 4 corners, all in the same town and range, may be recorded on this certificate.**

Description of original monument and accessories and/or subsequent restoration:

F-3 GLO March, 1832	LCRC L1-P165	LCRC L1-P231	
Calvin Britain, D.S.	3/4" pipe, Dec., 1971	Iron pipe, Jan., 1972	
Set post	N 45 W 33.62' 50" stump	Nail in face 12" Maple	N 10 W 68.10'
Beech 6	Nail MDSH Tag	Nail in face 4" Aspen	NW 49.02'
N 67 W 24	North 8.84' E edge	Steel fe. post	SE 45.80'
Beech 10	steel sign post	Street sign	SE 43.65'
S 35 E 25	S 30 E 45.82' face of		
	steel fe. cor. post		
	South 7.0' C/L gravel		OVER
	rd. E-W		

Description of corner evidence found and/or method applied in restoring or reestablishing corner:

F-3 Found Ottawa Co. Mon. (2" Harrison) in Mon. box  
 S 30 E fe. post 45.82',  
 45.80', 46.29'


And is accepted as a careful and faithful perpetuation of the position of the original corner.

PA. 345 OTTAWA COUNTY  
 PEER APPROVED 11/21/94

*Richard D. Peterson*

Description of monument for corner and accessories established to perpetuate locating the position of the corner:

F-3 Ottawa Co. Mon. (2" Harrison) in Mon. Box.  
 Nail & Ottawa Co. Remon. Tag in E side 12" Elm 8'± above ground N 00 E 92.83'  
 Nail & Ottawa Co. Remon. Tag in S side 16" Elm 6'± above ground N 65 W 132.07'  
 Nail & Ottawa Co. Remon. Tag in S side 12" Elm S 73 E 184.28'  
 Top C/L steel fe. post S 25 E 46.20'  
 C/L S end of CMP S 55 W 42.05'  
 On C/L bit. E-W, on C/L gravel S

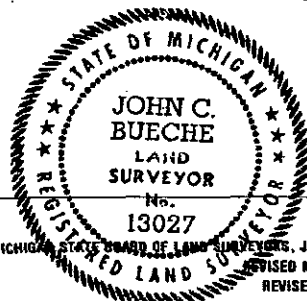

Witnessed by John C. Bueche  
 Surveyor's Michigan License No. 13027

Date 11-18-94

FORM APPROVED BY MICHIGAN STATE BOARD OF LAND SURVEYORS, JAN. 28, 1971  
 REVISED MAY 14, 1975  
 REVISED JAN., 1983

LCRC L4-P3

CIM Nov., 1979

C/L st. sign	SE 43.8'
Cor. angle iron fe. post (top)	SE 46.29'
C/L S end conc. culv.	SW 30.55'
C/L N end conc. culv.	NW 19.62'
Rd. warning sign	N 9.4'
C/L gravel E-W	S 7'±

0086 #  
0087 #  
0088 #  
0089 #