

**SURVEY &  
REMONUMENTATION**

APR 25 1995

COMMISSION

Ottawa County Remonumentation  
**LAND CORNER RECORDATION CERTIFICATE**  
Filing Requirement of Act 74, Mich. P.A. 1970

RECORDED

94 DEC -8 PM 12:38


*Richard Robinson*  
REGISTER OF DEEDS  
OTTAWA COUNTY, MI

corners in Ottawa (County)	Located In:	Corner Code #
Public Land Survey	T 5N R 14W	F-5 (S $\frac{1}{2}$ , 9)
	T _____ R _____	Zeeland Twp.
	T _____ R _____	
	T _____ R _____	
Property Controlling in Section	S _____ T _____ R _____	
Miscellaneous Property in Sec.	S _____ T _____ R _____	

Register of Deeds Stamp & File Number

Lot No. \_\_\_\_\_, Recorded Plat \_\_\_\_\_  
Private Claims \_\_\_\_\_

John C. Bueche, in a field survey on October 25, 19 94, hereby certify that under requirements of P.A. 74, Michigan P.A. of 1970, the corner points mentioned in lines 1 and 2 above were in conformance with regulations and rules therefore as required in the current manual of survey instructions of the United States Department of the Interior, Bureau of Land Management or by a decree of a Court of Law and/or that the corner points mentioned in lines 3, 4 and 5 above were in conformance with the rules of the Michigan Board of Land Surveyors or by a Decree of a Court of Law; established, re-established, monumented, re-monumented, recovered, found as pressed below:

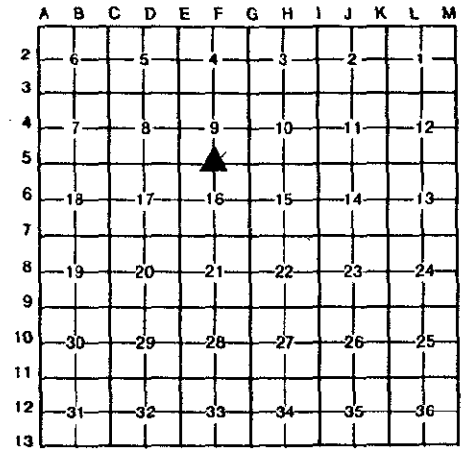

**NOTE: Not more than 4 corners, all in the same town and range, may be recorded on this certificate.**

Description of original monument and accessories and/or subsequent restoration:

F-5 GLO March, 1832	LCRC L4-P55	
Calvin Britain, D.S.	CIM, May, 1980	
Set post	MSHD Tie Tag in PP	SE 46.19'
Beech 10 S 40 W 25	MSHD Tie Tag in sawed PP	NW 69.91'
Sugar 9 N 62 E 9	PP	NE 116.20'
	C/L wood fence post	S 22.95'

Description of corner evidence found and/or method applied in restoring or reestablishing corner:

F-5 Found Ottawa Co. Mon. (4" Harrison) in gravel rd.		
	MSHD Tie Tag in PP	SE 46.19'
	PP	NE 116.20'

And is accepted as a careful and faithful perpetuation of the position of the original corner.

PA. 345 OTTAWA COUNTY  
PEER APPROVED 11/21/94  
*Richard Robinson*

Description of monument for corner and accessories established to perpetuate locating the position of the corner:

F-5 Ottawa Co. Mon. (4" Harrison) in gravel rd.  
"X" cut on 15" conc. culv. N 45 W 34.78'  
"X" cut on 15" conc. culv. N 40 E 24.23'  
"X" cut on 12" conc. culv. S 40 W 20.57'  
Nail & MSHD Tag in N side PP S 60 E 46.19'  
NW cor. hse. fnd. S 50 E 90.52'  
On C/L gravel rd. E-W  
C/L gravel rd. N, W 5'±, no rd. South



Signed by John C. Bueche Date 11-18-94  
Surveyor's Michigan License No. 13027