

**Ottawa County Remonumentation
LAND CORNER RECORDATION CERTIFICATE
Filing Requirement of Act 74, Mich. P.A. 1970**

For corners in

<u>Ottawa</u> (County)	Located In:	Corner Code #/
1. Public Land Survey	T <u>5N</u> R <u>14W</u>	F-7 (S <u>1</u> , <u>16</u>) <u>Zeeland Twp.</u>
	T _____ R _____	_____
	T _____ R _____	_____
	T _____ R _____	_____
2. Property Controlling in Section	S _____ T _____ R _____	_____
	S _____ T _____ R _____	_____
3. Miscellaneous Property in Sec.	S _____ T _____ R _____	_____
	S _____ T _____ R _____	_____
4. Lot No. _____, Recorded Plat _____		
5. Private Claims _____		

RECORDED

96 DEC 17 AM 10:43

Robert Williams
REGISTER OF DEEDS
OTTAWA COUNTY, MI

Register of Deeds Stamp & File Number

I, John C. Bueche, in a field survey on October 21, 19 96, do hereby certify that under requirements of P.A. 74, Michigan P.A. of 1970, the corner points mentioned in lines 1 and 2 above were in conformance with regulations and rules therefore as required in the current manual of survey instructions of the United States Department of the Interior, Bureau of Land Management or by a decree of a Court of Law and/or that the corner points mentioned in lines 3, 4 and 5 above were in conformance with the rules of the Michigan Board of Land Surveyors or by a Decree of a Court of Law; established, re-established, monumented, re-monumented, recovered, found as expressed below:

A	B	C	D	E	F	G	H	I	J	K	L	M
2	6	5	4	3	2	1						
3												
4	7	8	9	10	11	12						
5												
6	18	17	16	15	14	13						
7												
8	19	20	21	22	23	24						
9												
10	30	29	28	27	26	25						
11												
12	31	32	33	34	35	36						
13												

NOTE: Not more than 4 corners, all in the same town and range, may be recorded on this certificate.

A. Description of original monument and accessories and/or subsequent restoration:

F-7 GLO	LCRC L3, P94	LCRC L3, P108
1/4 sec. post on true line Elm	Nail in side fence post SW	Sept. 22, 1976 PK MSHD tag
10 is post	54.25'	Guard post S 55° W 31.19'
Calvin Britain March, 1832	Nail in side fence post SE	54" Maple SSE 106.90'
	Nail in side 60" Maple SSE	
	106.88'	
	PK N 1.81'	

OVER

B. Description of corner evidence found and/or method applied in restoring or reestablishing corner:

F-7 Found Nederveld & Associates capped iron in C/L Mon. Box All wit. gone, found Nederveld & Associates tags & PK's in poles Nederveld & Associates set corner 5/17/96 from information, distance from Holland Engineering, Kistler, MDOT, & CP Co. E-W & S Cor. is on line between NE cor. & NW cor. Sec. 21 (West 2728.66', East 2699.40', South 2629.71')

And is accepted as a careful and faithful perpetuation of the position of the original corner.


P.A. 345 OTTAWA COUNTY

PEER APPROVED 11-11-96

C. Description of monument for corner and accessories established to perpetuate locating the position of the corner:

F-7 Replaced Nederveld & Associates rered with Ottawa Co. Mon. (3/4" x 24" pin & cap) in Mon. Box
Nail & Ottawa Co. Remon. Tag in N side PP S 80° W 229.58'
Nail & Ottawa Co. Remon. Tag in E side PP S 44° E 43.54'
Nail & Ottawa Co. Remon. Tag in E side PP S 70° E 149.51'
West leg of sign post N 10° W 22.08'
On C/L bit. E-W, on C/L gravel South

\$ 11.00 CORNER
\$ 1.00 PHOTO
\$ 1.00 PHOTO

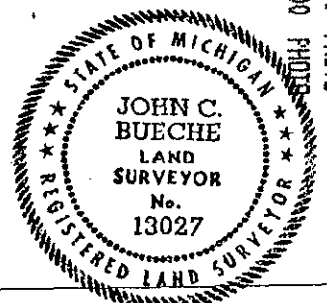

Signed by John C. Bueche
John C. Bueche, P.S. 13027
Surveyor's Michigan License No. _____

Date 11-7-96

F-7
LCRC L3, P286
Aug. 29, 1978 PK
Fence post SE 47.02'
Fence post SW 54.25'
60" Maple SSE 106.88'