

**SURVEY &
REMONUMENTATION**

APR 05 1996

COMMISSION

Ottawa County Remonumentation
LAND CORNER RECORDATION CERTIFICATE
Filing Requirement of Act 74, Mich. P.A. 1970

For corners in

| Ottawa (County) | Located In: | Corner Code # |
|---------------------------------------|--------------------------|----------------------------|
| 1. Public Land Survey | T <u>5N</u> R <u>14W</u> | F-9 (S $\frac{1}{2}$, 21) |
| | T _____ R _____ | Zeeland Twp. |
| | T _____ R _____ | _____ |
| | T _____ R _____ | _____ |
| 2. Property Controlling in Section | S _____ T _____ R _____ | _____ |
| | S _____ T _____ R _____ | _____ |
| 3. Miscellaneous Property in Sec. | S _____ T _____ R _____ | _____ |
| | S _____ T _____ R _____ | _____ |
| 4. Lot No. _____, Recorded Plat _____ | | |
| 5. Private Claims _____ | | |


RECORDED

95 NOV 29 PM 1:41

Elizabeth K. Johnson
REGISTER OF DEEDS
OTTAWA COUNTY, MI

Register of Deeds Stamp & File Number

I, John C. Bueche, in a field survey on November 17, 19 95, do hereby certify that under requirements of P.A. 74, Michigan P.A. of 1970, the corner points mentioned in lines 1 and 2 above were in conformance with regulations and rules therefore as required in the current manual of survey instructions of the United States Department of the Interior, Bureau of Land Management or by a decree of a Court of Law and/or that the corner points mentioned in lines 3, 4 and 5 above were in conformance with the rules of the Michigan Board of Land Surveyors or by a Decree of a Court of Law: established, re-established, monumented, re-monumented, recovered, found as expressed below:

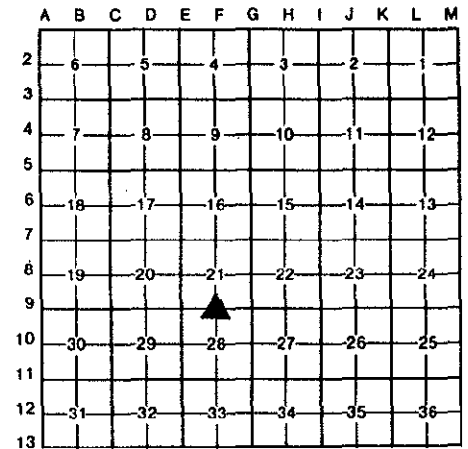

NOTE: Not more than 4 corners, all in the same town and range, may be recorded on this certificate.

A. Description of original monument and accessories and/or subsequent restoration:

| | | | |
|---|--|---|---|
| F-9 GLO Calvin Britain, D.S. April, 1832 Set 1/4 post on line 40.45' Beech 20 S 63 E 10 Sugar 12 N 8 W 28 | LCRC L4-P319 June, 1982 Iron pipe PP NW 42.51' PP NE 48.20' 20" Maple NE cor. porch SW 94.34' | LCRC L5-P295 March, 1988 Iron pipe Same wit. as L4-P319 | LCRC L5-P345 Dec., 1988 Set CIM PP NW 42.62' TP NE 48.06' NE cor. porch SW 94.50' |
|---|--|---|---|

B. Description of corner evidence found and/or method applied in restoring or reestablishing corner:

F-9 Found cast iron mon. down 0.6' in gravel rd.
As per above wit.


And is accepted as a careful and faithful perpetuation of the position of the original corner.

P.A. 345 OTTAWA COUNTY
PEER APPROVED 11/20/95

Robert P. Hedewald
RPH

C. Description of monument for corner and accessories established to perpetuate locating the position of the corner:

F-9 Cast iron mon. in gravel rd.
Existing Nail & Tag #14091 in side PP SE N 35 E 48.10'
Existing Nail & Tag #14091 in side PP S N 40 W 42.54'
NE cor. porch to hse #1595 S 55 W 94.42'
Nail & Ottawa Co. Remon. Tag in E side 24" Maple S 20 W 136.02'
C/L gravel East, South 6'±
C/L gravel N-S, East 2'±

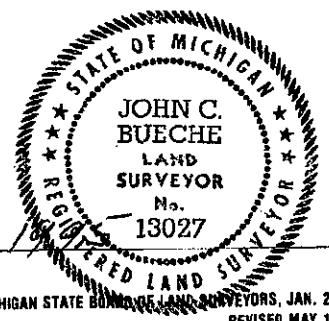

Signed by John C. Bueche
John C. Bueche, P.S. 13027
Surveyor's Michigan License No. _____

Date Nov 17, 1995