

**SURVEY &
REMONUMENTATION**

APR 05 1996

**Ottawa County Remonumentation
LAND CORNER RECORDATION CERTIFICATE
Filing Requirement of Act 74, Mich. P.A. 1970**

For corners in **COMMISSION**

| Ottawa (County) | Located In: | Corner Code # |
|---------------------------------------|-------------------------|-----------------------------|
| 1. Public Land Survey | T 5N R 14W | F-11 (S $\frac{1}{4}$, 28) |
| | T _____ R _____ | Zeeland Twp. |
| | T _____ R _____ | _____ |
| | T _____ R _____ | _____ |
| 2. Property Controlling in Section | S _____ T _____ R _____ | _____ |
| | S _____ T _____ R _____ | _____ |
| 3. Miscellaneous Property in Sec. | S _____ T _____ R _____ | _____ |
| | S _____ T _____ R _____ | _____ |
| 4. Lot No. _____, Recorded Plat _____ | | |
| 5. Private Claims _____ | | |

RECORDED

95 NOV 29 PM 1:41

Phyllis Kellerman
REGISTER OF DEEDS
OTTAWA COUNTY, MI

Register of Deeds Stamp & File Number

I, John C. Bueche, in a field survey on November 16, 19 95, do hereby certify that under requirements of P.A. 74, Michigan P.A. of 1970, the corner points mentioned in lines 1 and 2 above were in conformance with regulations and rules therefore as required in the current manual of survey instructions of the United States Department of the Interior, Bureau of Land Management or by a decree of a Court of Law and/or that the corner points mentioned in lines 3, 4 and 5 above were in conformance with the rules of the Michigan Board of Land Surveyors or by a Decree of a Court of Law; established, re-established, monumented, re-monumented, recovered, found as expressed below:

| | A | B | C | D | E | F | G | H | I | J | K | L | M |
|----|----|----|----|----|----|----|---|---|---|---|---|---|---|
| 2 | 6 | 5 | 4 | 3 | 2 | 1 | | | | | | | |
| 3 | | | | | | | | | | | | | |
| 4 | 7 | 8 | 9 | 10 | 11 | 12 | | | | | | | |
| 5 | | | | | | | | | | | | | |
| 6 | 18 | 17 | 16 | 15 | 14 | 13 | | | | | | | |
| 7 | | | | | | | | | | | | | |
| 8 | 19 | 20 | 21 | 22 | 23 | 24 | | | | | | | |
| 9 | | | | | | | | | | | | | |
| 10 | 30 | 29 | 28 | 27 | 26 | 25 | | | | | | | |
| 11 | | | | | | | | | | | | | |
| 12 | 31 | 32 | 33 | 34 | 35 | 36 | | | | | | | |
| 13 | | | | | | | | | | | | | |

NOTE: Not more than 4 corners, all in the same town and range, may be recorded on this certificate.

A. Description of original monument and accessories and/or subsequent restoration:

| | |
|---------------------------------------|--|
| F-11 GLO Calvin Britain, D.S. 1832 | LCRC L2-P735, Jan., 1975 RR spk. C/L bit. |
| Set 1/4 post on true line 40.56' | PP NE 47.84' |
| Hickory 14 S 86 E 22 | NW cor. garage SE 123.84' |
| Ironwood 9 N 36 W 12 | NW cor. W'ly hdw. ESE 75.55' |

B. Description of corner evidence found and/or method applied in restoring or reestablishing corner:

F-11 Found capped H.E.I. Iron in Mon. Box
NW cor. garage SE 123.84'


And is accepted as a careful and faithful perpetuation of the position of the original corner.

PA. 345 OTTAWA COUNTY
PEER APPROVED 11/20/95

Richard D. Hedwood
RDN

C. Description of monument for corner and accessories established to perpetuate locating the position of the corner:

| | |
|--|----------------|
| F-11 Replaced iron with 3/4" x 24" Pin with Ottawa Co. Cap in Mon. Box | S 30 E 123.65' |
| NW cor. garage fnd. | S 65 E 124.29' |
| Nail & Ottawa Co. Remon. Tag in NE side 8" Maple | S 30 W 59.28' |
| Nail & Ottawa Co. Remon. Tag in S side post at MBT Box | N 40 E 65.51' |
| Nail & Ottawa Co. Remon. Tag in NW side PP | |
| C/L bit. E-W, North 1'+ | |
| On C/L gravel South | |

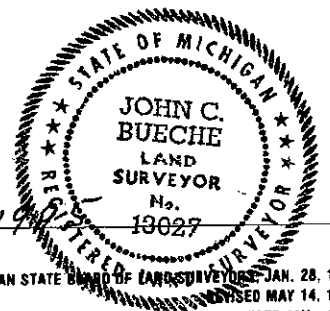

Signed by John C. Bueche
Surveyor's Michigan License No. 13027

Date Nov 17, 1995

FORM APPROVED BY MICHIGAN STATE BOARD OF LAND SURVEYORS, JAN. 28, 1971
REVISED MAY 14, 1975
REVISED JAN., 1983