

**SURVEY &
REMONUMENTATION**

APR 05 1996

**Ottawa County Remonumentation
LAND CORNER RECORDATION CERTIFICATE**

COMMISSION

Filing Requirement of Act 74, Mich. P.A. 1970

For corners in

Ottawa

(County)

Located In:

Corner Code #

- | | | |
|---------------------------------------|--------------------------|----------------------|
| 1. Public Land Survey | T <u>5N</u> R <u>14W</u> | <u>F-13 (S1, 33)</u> |
| | T ___ R ___ | <u>Zeeland Twp.</u> |
| | T ___ R ___ | _____ |
| | T ___ R ___ | _____ |
| 2. Property Controlling in Section | S ___ T ___ R ___ | _____ |
| | S ___ T ___ R ___ | _____ |
| 3. Miscellaneous Property in Sec. | S ___ T ___ R ___ | _____ |
| | S ___ T ___ R ___ | _____ |
| 4. Lot No. _____, Recorded Plat _____ | | |
| 5. Private Claims _____ | | |

RECORDED

95 NOV 29 PM 1:45

Richard R. Hartman
REGISTER OF DEEDS
OTTAWA COUNTY, MI

Register of Deeds Stamp & File Number

I, John C. Bueche, in a field survey on November 16, 19 95, do hereby certify that under requirements of P.A. 74, Michigan P.A. of 1970, the corner points mentioned in lines 1 and 2 above were in conformance with regulations and rules therefore as required in the current manual of survey instructions of the United States Department of the Interior, Bureau of Land Management or by a decree of a Court of Law and/or that the corner points mentioned in lines 3, 4 and 5 above were in conformance with the rules of the Michigan Board of Land Surveyors or by a Decree of a Court of Law; established, re-established, monumented, re-monumented, recovered, found as expressed below:

NOTE: Not more than 4 corners, all in the same town and range, may be recorded on this certificate.

A	B	C	D	E	F	G	H	I	J	K	L	M
2	6	5	4	3	2	1						
3												
4	7	8	9	10	11	12						
5												
6	18	17	16	15	14	13						
7												
8	19	20	21	22	23	24						
9												
10	30	29	28	27	26	25						
11												
12	31	32	33	34	35	36						
13												

A. Description of original monument and accessories and/or subsequent restoration:

F-13 GLO Lucuis	LCRC L2-P737	LCRC L3-P229, Dec., 1977	
Lyon, D.S.	Jan., 1975	T fe. post	
1832	Large "T" iron	Nail & Tag 18435 in face	
Set H.M.P.	12' E of C/L	18" Box Elder	SE 35.14'
Beech 24	gravel	Nail & Tag 18435 in face	
N 42 E 15	10" Ash	14" Sycamore	NE 49.12'
Beech 10	12" Ash NW	Nail & Tag 18435 in face	SW 94.12'
N 35 1/2 W 48	12" Box Elder	Nail & Tag 18435 in face	
	SW 95.16'	10" Ash stump	N 8.48'

B. Description of corner evidence found and/or method applied in restoring or reestablishing corner:

F-13 Found capped iron
 18" Sycamore NE 49.12'
 PP SW 94.12'
 24" Ash NE 55.36'
 12" Ash ESE 37.58'
 18" Maple NW 116.61'
 1/2" iron W 29.44' (N 1/4 Sec. 4, 4-14)

P.A. 345 OTTAWA COUNTY

PEER APPROVED 11-20-95

Richard P. Redwood
R.D.


And is accepted as a careful and faithful perpetuation of the position of the original corner.

C. Description of monument for corner and accessories established to perpetuate locating the position of the corner:

F-13 Replaced capped iron with 3/4" x 24" Pin with Ottawa Co. Cap
 Set Nail & Ottawa Co. Remon. Tag in SE side PP S 40 W 94.45'
 Set Nail & Ottawa Co. Remon. Tag in S side 14" Ash S 70 E 37.61'
 Set Nail & Ottawa Co. Remon. Tag in S side 30" Ash N 60 E 55.36'
 Set Nail & Ottawa Co. Remon. Tag in W side 20" Sycamore N 15 E 50.04'
 C/L gravel N-S, W 12'±
 C/L gravel W, S 3'±

Signed by John C. Bueche
 John C. Bueche, P.S. 13027
 Surveyor's Michigan License No. _____

Date Nov 17, 1995

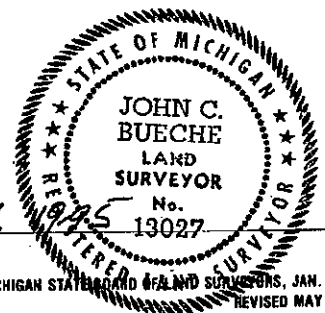

LCRC L6-P247

Feb., 1993

Set 1/2" iron

after construction

18" Sycamore NE 49.12'

PP SW 94.12'

24" Ash NE 55.36'

12" Ash ESE 37.58'

18" Maple NW 116.61'

1/2" iron W 29.44' (N 1/4 Sec. 4, 4-14)

\$ 11.00 CORNER