

**SURVEY &  
REMONUMENTATION**

APR 25 1995

**COMMISSION**

Ottawa County Remonumentation  
**LAND CORNER RECORDATION CERTIFICATE**  
Filing Requirement of Act 74, Mich. P.A. 1970

RECORDED

94 DEC -8 PH 12:38

*Ronald R. Callman*  
REGISTER OF DEEDS  
OTTAWA COUNTY, MI


corners in Ottawa (County)	Located In:	Corner Code #
Public Land Survey	T <u>5N</u> R <u>14W</u>	G-3 (SE, 4)
	T _____ R _____	<u>Zeeland Twp.</u>
	T _____ R _____	_____
	T _____ R _____	_____
Property Controlling in Section	S _____ T _____ R _____	_____
Miscellaneous Property in Sec.	S _____ T _____ R _____	_____

Register of Deeds Stamp & File Number

Lot No. \_\_\_\_\_, Recorded Plat \_\_\_\_\_  
Private Claims \_\_\_\_\_

John C. Bueche, in a field survey on October 25, 1994,  
hereby certify that under requirements of P.A. 74, Michigan P.A. of 1970, the corner points mentioned  
in lines 1 and 2 above were in conformance with regulations and rules therefore as required in the  
present manual of survey instructions of the United States Department of the Interior, Bureau of Land  
Management or by a decree of a Court of Law and/or that the corner points mentioned in lines 3, 4 and 5  
above were in conformance with the rules of the Michigan Board of Land Surveyors or by a Decree of a  
Court of Law; established, re-established, monumented, re-monumented, recovered, found as  
described below:

**Note: Not more than 4 corners, all in the same town and range, may be recorded  
on this certificate.**

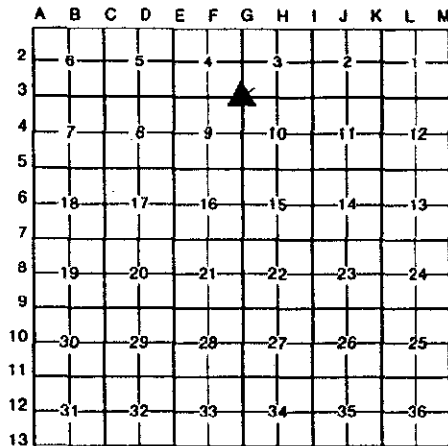

Description of original monument and accessories and/or subsequent restoration:

G-3 GLO March, 1832	LCRC L1-P167 1/2" iron. Dec., 1971	LCRC L1-P263 Steel rod, Feb., 1972
Calvin Britain, D.S.	Nail in PP N 50 W 47.20'	Nail in face TP NW 47.21'
Set cor.	Nail in PP N 35 E 65.50'	Nail in face TP SW 45.53'
White Ash 10	TP S 50 W 45.50'	Nail in face PP NE 65.61'
N 55 E 12		Street sign SE 41.60'
Hickory 20		OVER
S 42 W 9		

Description of corner evidence found and/or method applied in restoring or reestablishing corner:

G-3 Found Ottawa Co. Mon. (4" Harrison) in Mon. Box, no cover	Nail in PP N 35 E 65.50'	16" Mulberry NE 113.33'
		8" Elm SW 64.20'

And is accepted as a careful and faithful perpetuation of the position  
of the original corner.

P.A. 345 OTTAWA COUNTY  
PEER APPROVED 11/21/94


*Madison D. Nedwell*

Description of monument for corner and accessories established to perpetuate locating the position of the corner:

G-3 Ottawa Co. Mon. (4" Harrison) in Mon. Box, no cover	
Nail & Ottawa Co. Remon. Tag in SE side PP	N 35 E 65.95'
Nail & Ottawa Co. Remon. Tag in SW side dbl. 24" Mulberry	N 40 W 114.06'
Nail & Ottawa Co. Remon. Tag in SE side 24" Elm	S 58 W 64.13'
Nail & Ottawa Co. Remon. Tag in NE side PP	S 50 E 47.03'
NW cor. brick garg.	S 32 E 150.94'
On C/L bit. N-S & E-W	

Surveyed by John C. Bueche  
Surveyor's Michigan License No. 13027

Date 11-18-94

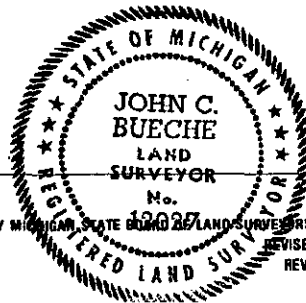

FORM APPROVED BY MICHIGAN STATE BOARD OF LAND SURVEYORS, JAN. 28, 1971  
REVISED MAY 14, 1975  
REVISED JAN., 1983

LCRC L5-P261

CIM, Aug., 1986

Nail in face PP NE 65.60'

Street sign SE 41.80'

16" Mulberry NW 113.33'

8" Elm SW 64.20'

1986  
AUG 15  
10 30 AM  
LCRC