

SURVEY & REMONUMENTATION

APR 25 1995

COMMISSION

Ottawa County Remonumentation
LAND CORNER RECORDATION CERTIFICATE
 Filing Requirement of Act 74, Mich. P.A. 1970

RECORDED
 94 DEC -8 PM 12:38

Richard D. Peterson
 REGISTER OF DEEDS
 OTTAWA COUNTY, MI

corners in
Ottawa
 (County)


Located In:	Corner Code #
T 5N R 14W	G-4 (E $\frac{1}{2}$, 9)
T _____ R _____	Zeeland Twp.
T _____ R _____	_____
T _____ R _____	_____
T _____ R _____	_____
S _____ T _____ R _____	_____
S _____ T _____ R _____	_____
S _____ T _____ R _____	_____
S _____ T _____ R _____	_____

Register of Deeds Stamp & File Number

Lot No. _____, Recorded Plat _____
 Private Claims _____

John C. Bueche, in a field survey on October 18, 1994,
 hereby certify that under requirements of P.A. 74, Michigan P.A. of 1970, the corner points mentioned
 in lines 1 and 2 above were in conformance with regulations and rules therefore as required in the
 current manual of survey instructions of the United States Department of the Interior, Bureau of Land
 Management or by a decree of a Court of Law and/or that the corner points mentioned in lines 3, 4 and 5
 above were in conformance with the rules of the Michigan Board of Land Surveyors or by a Decree of a
 Court of Law; established, re-established, monumented, re-monumented, recovered, found as
 pressed below:

**NOTE: Not more than 4 corners, all in the same town and range, may be recorded
 on this certificate.**

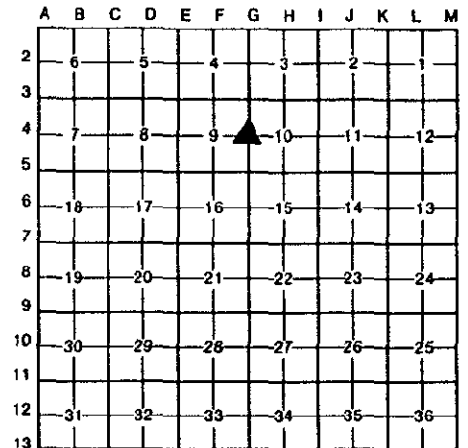

Description of original monument and accessories and/or subsequent restoration:

G-4 GLO March, 1832	LCRC L1-P169 Conc. Mon., Dec., 1971	LCRC L1-P263 Conc. Mon., Feb., 1972
Calvin Britain, D.S.	Spk. in TP S 10 W 104.47'	Nail in face TP S 5 W 104.58'
Set 1/2 mile post	Nail in PP S 35 E 71.46'	Nail in face PP SE 71.45'
Black Ash 20	C/L pav't. E 15.7'	Nail in face GP S 30 W 69.52'
N 20 E 55	Iron W 49.85'	Nail in face TP NW 82.45'
Black Ash 24		
S 38 W 39		

Description of corner evidence found and/or method applied in restoring or reestablishing corner:

G-4 Found 4" square Conc. Mon.
 C/L bit. E 15.65'
 Cut off TP S 5 W 104.58'

And is accepted as a careful and faithful perpetuation of the position
 of the original corner.


P.A. 345 OTTAWA COUNTY
 PEER APPROVED: 11/21/94
Richard D. Peterson

Description of monument for corner and accessories established to perpetuate locating the position of the corner:

G-4 Placed Ottawa Co. Alum. Cap in conc. on top of square Conc. Mon.	
Nail & Ottawa Co. Remon. Tag in top of cut off TP	S 5 W 105.38'
Nail & Ottawa Co. Remon. Tag in C/L bit. rd. @ C/L tracks	S 0 E 148.50'
Nail & Ottawa Co. Remon. Tag in SE side PP 6'± above ground	N 40 E 90.84'
Nail & Ottawa Co. Remon. Tag in C/L RR tracks	S 45 W 228.01'
Large Nail on C/L bit. rd.	N 35 E 31.45'
C/L bit. E 15.7'±, on field division W	

Signed by John C. Bueche
 John C. Bueche
 Surveyor's Michigan License No. 13027

Date 11-18-94

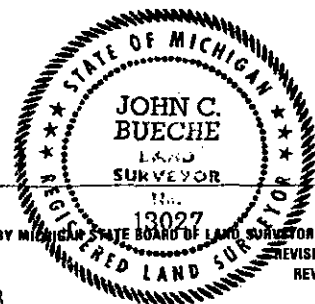

FORM APPROVED BY MICHIGAN STATE BOARD OF LAND SURVEYORS, JAN. 28, 1971
 REVISED MAY 14, 1975
 REVISED JAN., 1983