

1888
COMMISSION

Ottawa County Remonumentation
LAND CORNER RECORDATION CERTIFICATE
Filing Requirement of Act 74, Mich. P.A. 1970

RECORDED

93 DEC 15 AM 9:31


John C. Bueche
REGISTER OF DEEDS
OTTAWA COUNTY, MI

For corners in

Ottawa (County)	Located In:	Corner Code #
1. Public Land Survey	T <u>5N</u> R <u>14W</u>	<u>G-7 (SE, 16)</u> <u>Zeeland Twp.</u>
	T _____ R _____	_____
	T _____ R _____	_____
	T _____ R _____	_____
2. Property Controlling in Section	S _____ T _____ R _____	_____
	S _____ T _____ R _____	_____
3. Miscellaneous Property in Sec.	S _____ T _____ R _____	_____
	S _____ T _____ R _____	_____

Register of Deeds Stamp & File Number

4. Lot No. _____, Recorded Plat _____
5. Private Claims _____

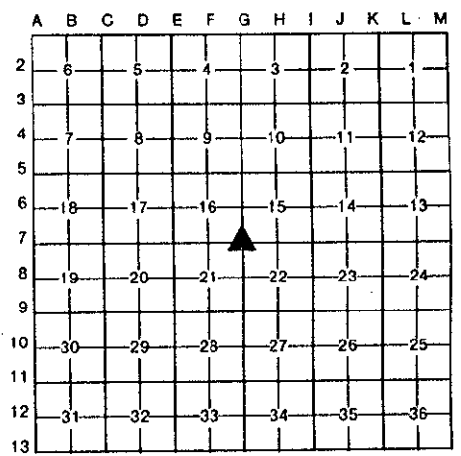

I, John C. Bueche, in a field survey on November 29, 1993, do hereby certify that under requirements of P.A. 74, Michigan P.A. of 1970, the corner points mentioned in lines 1 and 2 above were in conformance with regulations and rules therefore as required in the current manual of survey instructions of the United States Department of the Interior, Bureau of Land Management or by a decree of a Court of Law and/or that the corner points mentioned in lines 3, 4 and 5 above were in conformance with the rules of the Michigan Board of Land Surveyors or by a Decree of a Court of Law; established, re-established, monumented, re-monumented, recovered, found as expressed below:

NOTE: Not more than 4 corners, all in the same town and range, may be recorded on this certificate.

A. Description of original monument and accessories and/or subsequent restoration:

G-7 LCRC (L2, P511) July 9, 1974	G-7 LCRC (L5, P296) March 18, 1988
Found iron pipe	1/2" iron bar
TP N 50° E 48.92'	PP S 30° E 52.68'
PP S 30° E 52.77'	Conc. post N 45° W 37.98'
Conc. post N 45° W 37.98'	TP N 40° E 48.87'
	SE cor. of hse. N 40° W 96.61'

B. Description of corner evidence found and/or method applied in restoring or reestablishing corner:

G-7 Found 3/4" pipe in Mon. Box (no cover), bent over broken O.C. Mon. (Harrison)	
PP S 30° E 52.77'	PP S 30° E 52.68'
	SE cor. of hse. N 40° W 96.61'

And is accepted as a careful and faithful perpetuation of the position of the original corner.

C. Description of monument for corner and accessories established to perpetuate locating the position of the corner:

G-7 Set Cap in conc. over 3/4" pipe in Mon. Box (no cover)	
Conc. Nail & O.C. Remon. Tag in W side PP	S 30° E 52.67'
NE cor. hse. fnd.	N 30° W 127.65'
SE cor. hse. frame	N 50° W 95.10'
"X" cut in N end CMP (& drill hole)	N 55° E 52.15'
On C/L bit. E & W	
C/L gravel road S is E 6'±	
C/L gravel road N is E 2'±	



Signed by John C. Bueche Date Nov. 29, 1993
Surveyor's Michigan License No. 13027