

SURVEY &  
REMONUMENTATION

FEB 18 1984

COMMISSION

Ottawa County Remonumentation  
LAND CORNER RECORDATION CERTIFICATE  
Filing Requirement of Act 74, Mich. P.A. 1970

RECORDED

93 NOV -8 PM 1:57

*John C. Bueche*  
REGISTER OF DEEDS  
OTTAWA COUNTY, MI

For corners in  
Ottawa

(County)

Located In:

Corner Code #

1. Public Land Survey	T <u>5N</u> R <u>14W</u>	G-8 (E $\frac{1}{4}$ , 21)
	T _____ R _____	Zeeland Twp.
	T _____ R _____	_____
	T _____ R _____	_____
2. Property Controlling in Section	S _____ T _____ R _____	_____
	S _____ T _____ R _____	_____
3. Miscellaneous Property in Sec.	S _____ T _____ R _____	_____
	S _____ T _____ R _____	_____

Register of Deeds Stamp & File Number

4. Lot No. \_\_\_\_\_, Recorded Plat \_\_\_\_\_  
5. Private Claims \_\_\_\_\_

	A	B	C	D	E	F	G	H	I	J	K	L	M
2	6	5	4	3	2	1							
3													
4	7	8	9	10	11	12							
5													
6	18	17	16	15	14	13							
7													
8	19	20	21	22	23	24							
9													
10	30	29	28	27	26	25							
11													
12	31	32	33	34	35	36							
13													

I, John C. Bueche, in a field survey on October, 1993, do hereby certify that under requirements of P.A. 74, Michigan P.A. of 1970, the corner points mentioned in lines 1 and 2 above were in conformance with regulations and rules therefore as required in the current manual of survey instructions of the United States Department of the Interior, Bureau of Land Management or by a decree of a Court of Law and/or that the corner points mentioned in lines 3, 4 and 5 above were in conformance with the rules of the Michigan Board of Land Surveyors or by a Decree of a Court of Law; established, re-established, monumented, re-monumented, recovered, found as expressed below:

**NOTE: Not more than 4 corners, all in the same town and range, may be recorded on this certificate.**

A. Description of original monument and accessories and/or subsequent restoration:

G-8 (L4, P319) June 10, 1982  
PP NE 144.19'  
18" Apple SE 139.55'  
C/L st. sign SE 49.65'  
SW bridge post N 129.75'

G-8 (L5, P186) December 27, 1984  
Set C.I.M.  
PP NE 144.46'  
St. sign SE 49.65'  
Willow clump SE 73.22'  
Sign post SW 3.8'

B. Description of corner evidence found and/or method applied in restoring or reestablishing corner:

G-8 Found O.C. Harrison Mon., down 6"± below ground in good condition

PP NE 144.19'  
Sign post SW 3.8'  
St. sign SE 49.65'


C. Description of monument for corner and accessories established to perpetuate locating the position of the corner:

G-8 O.C. Harrison Mon. 6"± below ground  
O.C. Remon. Tag & Nail in SW side PP N 45° E 144.87'  
O.C. Remon. Tag & Nail in E side 18" Willow N 5° W 76.97'  
O.C. Remon. Tag & Nail in S side dbl. 8" Ash S 43° E 115.88'  
O.C. Remon. Tag & Nail in W side 10" Willow in clump S 8° E 120.04'  
O.C. Remon. Tag & Nail in W side 6" Box Elder S 27° W 22.93'  
C/L N & S road is 15' E±  
C/L gravel road E is S 8'±  
Meas. by EDM

Signed by John C. Bueche

Date Oct. 18, 1993

Surveyor's Michigan License No. 13027

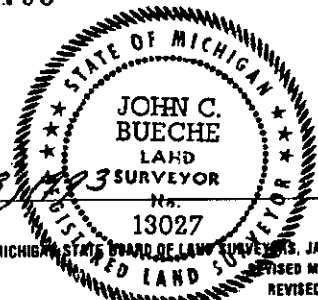

FORM APPROVED BY MICHIGAN STATE BOARD OF LAND SURVEYORS, JAN. 28, 1971  
REVISED MAY 14, 1975  
REVISED JAN., 1983