

SURVEY &
REMONUMENTATION

FEB 18 1994

COMMISSION

Ottawa County Remonumentation
LAND CORNER RECORDATION CERTIFICATE
Filing Requirement of Act 74, Mich. P.A. 1970

RECORDED

93 NOV -8 PM 1:57

Dorothy A. Chalmers
REGISTER OF DEEDS
OTTAWA COUNTY, MI

For corners in

Ottawa

(County)

Located In:

Corner Code #

- | | | |
|------------------------------------|--------------------------|---------------------|
| 1. Public Land Survey | T <u>5N</u> R <u>14W</u> | G-9 (SE, 21) |
| | T _____ R _____ | <u>Zeeland Twp.</u> |
| | T _____ R _____ | _____ |
| | T _____ R _____ | _____ |
| 2. Property Controlling in Section | S _____ T _____ R _____ | _____ |
| | S _____ T _____ R _____ | _____ |
| 3. Miscellaneous Property in Sec. | S _____ T _____ R _____ | _____ |
| | S _____ T _____ R _____ | _____ |

Register of Deeds Stamp & File Number

4. Lot No. _____, Recorded Plat _____
5. Private Claims _____

I, John C. Bueche, in a field survey on October, 19 93, do hereby certify that under requirements of P.A. 74, Michigan P.A. of 1970, the corner points mentioned in lines 1 and 2 above were in conformance with regulations and rules therefore as required in the current manual of survey instructions of the United States Department of the Interior, Bureau of Land Management or by a decree of a Court of Law and/or that the corner points mentioned in lines 3, 4 and 5 above were in conformance with the rules of the Michigan Board of Land Surveyors or by a Decree of a Court of Law; established, re-established, monumented, re-monumented, recovered, found as expressed below:

A	B	C	D	E	F	G	H	I	J	K	L	M
2	6	5	4	3	2	1						
3												
4	7	8	9	10	11	12						
5												
6	18	17	16	15	14	13						
7												
8	19	20	21	22	23	24						
9												
10	30	29	28	27	26	25						
11												
12	31	32	33	34	35	36						
13												

NOTE: Not more than 4 corners, all in the same town and range, may be recorded on this certificate.

A. Description of original monument and accessories and/or subsequent restoration:

G-9 (L4, P319) June 10, 1982	G-9 (L5, P345) Dec. 6, 1988
PP NW 119.36'	Set C.I.M.
Fence post S 20.73'	PP SE 159.2'
Fence post SW 31.23'	PK in cor. fence
PP ESE 164.34'	post S 20.91'
	PP NW 119.45'


B. Description of corner evidence found and/or method applied in restoring or reestablishing corner:

G-9 Found O.C. Harrison Mon. in good condition, flush with gravel road

PP NW 119.45'	PP NW Nail & Tag
PK in cor. fence post S 20.91'	#14091 119.50'
PP SE 159.2'	

C. Description of monument for corner and accessories established to perpetuate locating the position of the corner:

G-9 O.C. Harrison Mon. flush with gravel road
"X" cut E end conc. culvert N 15° E 181.51'
Nail & Tag NE side PP N 20° W 119.50' R.L.S. #14091
O.C. Remon. Tag & Nail in S side PP S 2° W 258.28'
O.C. Remon. Tag & Nail in W side 6" Elm S 109.08'
O.C. Remon. Tag & Nail in N side PP N 80° E 324.71'
On C/L gravel E & W
C/L gravel N is E 10'±
On C/L fence to S
Meas. by EDM

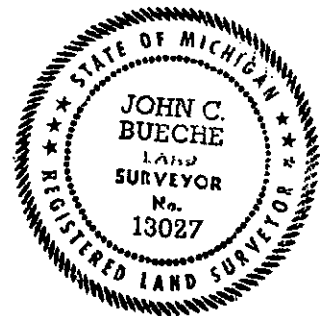

Signed by John C. Bueche Date Oct 18, 1993
Surveyor's Michigan License No. 13027