

SURVEY &
REMONUMENTATION

FEB 18 1994

COMMISSION

For corners in

Ottawa

(County)

Located in:

Corner Code #

- | | | |
|------------------------------------|--------------------------|---------------------|
| 1. Public Land Survey | T <u>5N</u> R <u>14W</u> | G-10 (E 1/4, 28) |
| | T _____ R _____ | <u>Zeeland Twp.</u> |
| | T _____ R _____ | _____ |
| | T _____ R _____ | _____ |
| 2. Property Controlling in Section | S _____ T _____ R _____ | _____ |
| | S _____ T _____ R _____ | _____ |
| 3. Miscellaneous Property in Sec. | S _____ T _____ R _____ | _____ |
| | S _____ T _____ R _____ | _____ |

4. Lot No. _____, Recorded Plat _____
5. Private Claims _____

RECORDED

93 NOV -8 PM 1:58

Polycarpus Chalmers
REGISTER OF DEEDS
OTTAWA COUNTY, MI

Register of Deeds Stamp & File Number

I, John C. Bueche, in a field survey on October, 19 93, do hereby certify that under requirements of P.A. 74, Michigan P.A. of 1970, the corner points mentioned in lines 1 and 2 above were in conformance with regulations and rules therefore as required in the current manual of survey instructions of the United States Department of the Interior, Bureau of Land Management or by a decree of a Court of Law and/or that the corner points mentioned in lines 3, 4 and 5 above were in conformance with the rules of the Michigan Board of Land Surveyors or by a Decree of a Court of Law; established, re-established, monumented, re-monumented, recovered, found as expressed below:

NOTE: Not more than 4 corners, all in the same town and range, may be recorded on this certificate.

A. Description of original monument and accessories and/or subsequent restoration:


G-10 (L3, P192) Sept. 23, 1977
C.I.M.
Field line N & S
NW cor. G-9 N 2650.81'
SW cor. G-11 S 2336.76'
E 1/4 cor. I-10 E 5350.43'

B. Description of corner evidence found and/or method applied in restoring or reestablishing corner:

G-10 Found O.C. Harrison Mon. in good condition
Found Nail & Cap #01642 93.86' W side 18" Oak S
Found Nail & Cap #01642 92.18' W side 18" Oak N
Did not check distances

C. Description of monument for corner and accessories established to perpetuate locating the position of the corner:

G-10 O.C. Harrison Mon.
O.C. Remon. Tag & Nail W side 18" Oak S 0° W 93.86'
1" iron pipe .25' S of O.C. Harrison Mon.
O.C. Remon. Tag & Nail W side dbl. 18" Oak N 0° E 92.18'
1 1/4" pipe 2' above ground .9' E
No other wits. available
No field division E or W
On field line N & S
Meas. by hand

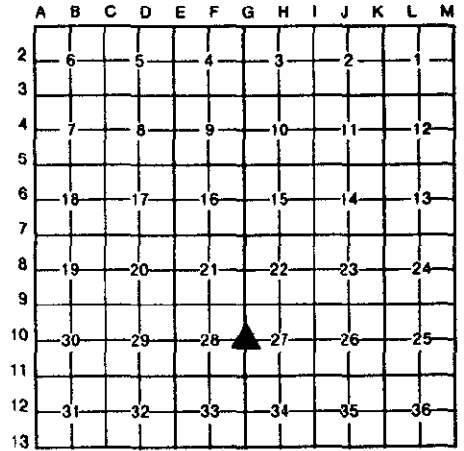

Signed by John C Bueche Date Oct 18, 1993
Surveyor's Michigan License No. 13027

