

FEB 24 2000

OTTAWA COUNTY REMONUMENTATION
LAND CORNER RECORDATION CERTIFICATE
Filing Requirement of Act 74, Mich. P.A. 1970

RECORDED

99 SEP 23 PM 3: 20

For corners in SECTION

<u>OTTAWA</u>		Located In:	Corner Code #
(County)		<u>ZEELAND TOWNSHIP</u>	
1. Public Land Survey		<u>T 5N R14W</u>	<u>H-1</u>
		<u>T R</u>	<u>N 1/4 Corner</u>
		<u>T R</u>	<u>Section 3</u>
		<u>T R</u>	
2. Property Controlling in Section	<u>S</u>	<u>T R</u>	
	<u>S</u>	<u>T R</u>	
3. Miscellaneous Property In Sec.	<u>S</u>	<u>T R</u>	
	<u>S</u>	<u>T R</u>	

Roy Sublett
REGISTER OF DEEDS
OTTAWA COUNTY, MI

Register of Deeds Stamp & File Number

4. Lot No. _____, Recorded Plat _____
5. Private Claims _____

I, Rodney D. Unema, in a field survey on September 16, 1999 do hereby state that under requirements of P.A. 74, Michigan P.A. of 1970, the corner points mentioned in lines 1 and 2 above were in conformance with regulations and rules therefore as required in the current manual of survey instructions of the United States Department of the Interior, Bureau of Land Management or by a decree of a Court of Law and for that the corner points mentioned in lines 3, 4 and 5 above were in conformance with the rules of the Michigan Board of Land Surveyors or by a Decree of a Court of Law; established, re-established, monumented, recovered, found as expressed below:

NOTE: Not more than 2 corners, all in the same town and range, may be recorded on this certificate.

A	B	C	D	E	F	G	H	I	J	K	L	M
1							▲					
2	6		5		4		3		2		1	
3												
4	7		8		9		10		11		12	
5												
6	18		17		16		15		14		13	
7												
8	19		20		21		22		23		24	
9												
10	30		29		28		27		26		25	
11												
12	31		32		33		34		35		36	
13												

A. Description of original monument and accessories and/or subsequent restoration:

H-1 N 1/4 Corner, Section 3
Corner not set by G.L.O.

March 7, 1978 (Nederveid)
Liber 3, page 261
Found "T" iron

Spk on E. side 24" Maple	SSW	38.7'
Spk on NE side 18" Oak	ESE	74.12'
Spk on E side 10" Ash	SW	42.65'

B. Description of corner evidence found and/or method applied in restoring or reestablishing corner:

H-1 Fnd "T" Iron in gravel road 0.04' North of Township line.
Fnd Spk in E. side 24" Maple S20°W 38.96'
Fnd Spk mark & pull in E. side of 12" Ash S52°W 42.63' *OVER FOR SKETCH
Fnd "T" iron @ Blendon Cor H-13 East 41.50'
Centerline gravel road South 1'

Set Ottawa County Cap on 3/4" x 24" bar 0.04' South of "T" Iron - removed "T" Iron


This position not established by original government surveyors. This monument is accepted as the best available evidence of the position of the corner.

9/20/99
[Signature]

C. Description of monument for corner and accessories established to perpetuate locating the position of the corner:

H-1 Ottawa Co. Cap on 3/4" x 24" Bar in E-W Gravel Road (New Holland Street)
Top of Cap is +/- 6" below gravel surface.

Set nail & O.C. remon tag in W side of 12" Cottonwood	S34°E	35.78'
Set nail & O.C. remon tag in E side of 24" Maple	S20°W	38.92'
Set nail & O.C. remon tag in E side of 12" Ash	S52°W	42.85'
Set nail & O.C. remon tag in W side of 4" Hickory	N41°E	80.18'
H-13 T6N, R14W, Ottawa Co. mon.	N90°E	41.50'
Centerline of E-W gravel road	South	+/- 1'

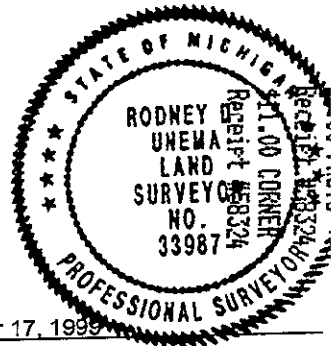

Signed by Rodney D. Unema
Surveyor's Michigan License No. 33987

Date September 17, 1999

FEB 24 2000

SECTION

