

**SURVEY & REMONUMENTATION**

APR 24 1995

**COMMISSION**

Ottawa County Remonumentation  
**LAND CORNER RECORDATION CERTIFICATE**  
 Filing Requirement of Act 74, Mich. P.A. 1970

RECORDED

94 DEC 15 AM 11:49

*R. J. ...*  
 REGISTER OF DEEDS  
 OTTAWA COUNTY, MI


For corners in

Ottawa <small>(County)</small>	Located In:	Corner Code #
1. Public Land Survey	T <u>5N</u> R <u>14W</u>	<u>H-5(S<math>\frac{1}{4}</math>, 10)</u> <u>Zeeland Twp.</u>
	T _____ R _____	_____
	T _____ R _____	_____
	T _____ R _____	_____
2. Property Controlling in Section	S _____ T _____ R _____	_____
	S _____ T _____ R _____	_____
3. Miscellaneous Property in Sec.	S _____ T _____ R _____	_____
	S _____ T _____ R _____	_____

Register of Deeds Stamp & File Number

4. Lot No. \_\_\_\_\_, Recorded Plat \_\_\_\_\_  
 5. Private Claims \_\_\_\_\_

I, John C. Bueche, in a field survey on December 6, 19 94, do hereby certify that under requirements of P.A. 74, Michigan P.A. of 1970, the corner points mentioned in lines 1 and 2 above were in conformance with regulations and rules therefore as required in the current manual of survey instructions of the United States Department of the Interior, Bureau of Land Management or by a decree of a Court of Law and/or that the corner points mentioned in lines 3, 4 and 5 above were in conformance with the rules of the Michigan Board of Land Surveyors or by a Decree of a Court of Law; established, re-established, monumented, re-monumented, recovered, found as expressed below:

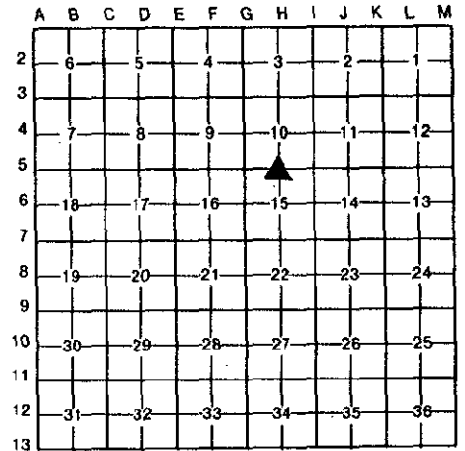

**NOTE: Not more than 4 corners, all in the same town and range, may be recorded on this certificate.**

A. Description of original monument and accessories and/or subsequent restoration:

H-5 GLO, March, 1832	LCRC L1-P351
Calvin Britain, D.S.	April, 1972
Set post on line	Iron pipe
Sugar 14 S 21 W 35	Nail in face of PP SW 75.97'
Sugar 14 N 5 E 8	Nail in face of TP NW 34.30'
	Nail in face of TP NE 90.69'

B. Description of corner evidence found and/or method applied in restoring or reestablishing corner:

H-5 Found iron pipe in Mon. Box  
 As per above wit.

And is accepted as a careful and faithful perpetuation of the position of the original corner.

PA. 345 OTTAWA COUNTY  
 PEER APPROVED 12/12/94  
*Wesley D. Nedeweld*

C. Description of monument for corner and accessories established to perpetuate locating the position of the corner:

H-5 Replaced iron with Ottawa Co. Mon. (3/4" x 24" Pin with Alum. Cap) in Mon. Box

Nail & Ottawa Co. Remon. Tag in W side PP	N 15 W 191.56'
Nail & Ottawa Co. Remon. Tag in N side 4" Maple	N 60 W 99.49'
Nail & Ottawa Co. Remon. Tag in top of 8"x 8" cor. fe. post	S 45 W 38.81'
Nail & Ottawa Co. Remon. Tag in S side PP	S 70 W 76.45'

On C/L bit. E & W  
 C/L gravel rd. N, E 4'±; on C/L gravel S

Signed by John C. Bueche Date 12-12-94  
 Surveyor's Michigan License No. 13027



FORM APPROVED BY MICHIGAN STATE BOARD OF LAND SURVEYORS: JAN. 28, 1971  
 REVISED MAY 14, 1975  
 REVISED JAN., 1983