

RECORDED

RECORDED

93 DEC 15 AM 9:31

1993

Ottawa County Remonumentation
LAND CORNER RECORDATION CERTIFICATE

COMMISSION

Filing Requirement of Act 74, Mich. P.A. 1970

For corners in

Ottawa

(County)

Located In:

Corner Code #/

- 1. Public Land Survey T 5N R 14W H-7 (S $\frac{1}{4}$, 15)
T _____ R _____ Zeeland Twp.
T _____ R _____
T _____ R _____
- 2. Property Controlling S _____ T _____ R _____
in Section S _____ T _____ R _____
- 3. Miscellaneous S _____ T _____ R _____
Property in Sec. S _____ T _____ R _____

Register of Deeds Stamp & File Number

John C. Bueche
REGISTER OF DEEDS
OTTAWA COUNTY, MI

- 4. Lot No. _____, Recorded Plat _____
- 5. Private Claims _____

I, John C. Bueche, in a field survey on November, 19 93, do hereby certify that under requirements of P.A. 74, Michigan P.A. of 1970, the corner points mentioned in lines 1 and 2 above were in conformance with regulations and rules therefore as required in the current manual of survey instructions of the United States Department of the Interior, Bureau of Land Management or by a decree of a Court of Law and/or that the corner points mentioned in lines 3, 4 and 5 above were in conformance with the rules of the Michigan Board of Land Surveyors or by a Decree of a Court of Law; established, re-established, monumented, re-monumented, recovered, found as expressed below:

NOTE: Not more than 4 corners, all in the same town and range, may be recorded on this certificate.

A. Description of original monument and accessories and/or subsequent restoration:

H-7 LCRC (L1, P287)	H-7 LCRC (L1, P351)	H-7 LCRC (L5, P298)
March 8, 1972	April 10, 1972	March 18, 1988
Set PK nail	Found PK nail	C.I.M.
Nail in face of TP	Nail in face of PP NE 52.97'	SW hse. cor. NE 108.39'
N 50° E 52.88'	Nail in face of TP NW 61.89'	NW hse. cor. SE 141.90'
Nail in face of PP	Nail in face of PP	TP NW 61.89'
S 05° W 44.32'	S 5° W 44.24'	PP NE 52.95'
Nail in face of TP	SW hse. cor. NE 108.39'	PP SW 44.28'
N 55° W 61.89'	NW hse. cor. SE 141.90'	


B. Description of corner evidence found and/or method applied in restoring or reestablishing corner:

H-7 Found O.C. Mon. (4" Harrison) down 8" in Mon. Box		
Nail in face of TP	Nail in face of PP NE 52.97'	SW hse. cor. NE 108.39'
N 50° E 52.88'	Nail in face of PP	NW hse. cor. SE 141.90'
Nail in face of PP	S 5° W 44.24'	PP NE 52.95'
S 05° W 44.32'	SW hse. cor. NE 108.39'	PP SW 44.28'
	NW hse. cor. SE 141.90'	

And is accepted as a careful and faithful perpetuation of the position of the original corner.

C. Description of monument for corner and accessories established to perpetuate locating the position of the corner:

H-7 O.C. Mon. (4" Harrison) in Mon. Box	
Conc. Nail & O.C. Remon. Tag in E side PP	S 10° W 44.27'
C/L 8" Maple	N 45° W 77.25'
NW cor. conc. drwy.	S 40° E 119.42'
"X" cut on W end conc. culvt.	S 65° W 58.05'
SW cor. brick hse.	N 45° E 108.31'
On C/L bit. road E & W	
C/L bit. road N is W 5'±	

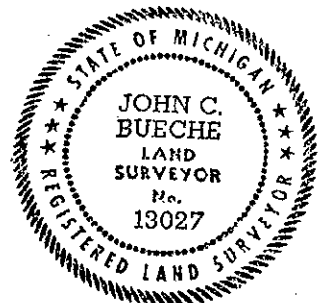

Signed by John C. Bueche Date Nov. 29, 1993
Surveyor's Michigan License No. 13027