

**SURVEY & REMONUMENTATION**

APR 24 1995

**COMMISSION**

Ottawa County Remonumentation  
**LAND CORNER RECORDATION CERTIFICATE**  
 Filing Requirement of Act 74, Mich. P.A. 1970

RECORDED

94 DEC 15 AM 11:49

*Phyllis Callman*  
 REGISTER OF DEEDS  
 OTTAWA COUNTY, MI

For corners in

Ottawa (County)	Located In:	Corner Code #
1. Public Land Survey	T <u>5N</u> R <u>14W</u>	<u>I-3 (SE, 3)</u> <u>Zeeland Twp.</u>
	T ___ R ___	_____
	T ___ R ___	_____
	T ___ R ___	_____
2. Property Controlling in Section	S ___ T ___ R ___	_____
	S ___ T ___ R ___	_____
3. Miscellaneous Property in Sec.	S ___ T ___ R ___	_____
	S ___ T ___ R ___	_____

Register of Deeds Stamp & File Number

4. Lot No. \_\_\_\_\_, Recorded Plat \_\_\_\_\_  
 5. Private Claims \_\_\_\_\_

	A	B	C	D	E	F	G	H	I	J	K	L	M
2	6	5	4	3	2	1							
3									▲				
4	7	8	9	10	11	12							
5													
6	18	17	16	15	14	13							
7													
8	19	20	21	22	23	24							
9													
10	30	29	28	27	26	25							
11													
12	31	32	33	34	35	36							
13													

I, John C. Bueche, in a field survey on December 6, 19 94, do hereby certify that under requirements of P.A. 74, Michigan P.A. of 1970, the corner points mentioned in lines 1 and 2 above were in conformance with regulations and rules therefore as required in the current manual of survey instructions of the United States Department of the Interior, Bureau of Land Management or by a decree of a Court of Law and/or that the corner points mentioned in lines 3, 4 and 5 above were in conformance with the rules of the Michigan Board of Land Surveyors or by a Decree of a Court of Law; established, re-established, monumented, re-monumented, recovered, found as expressed below:

**NOTE: Not more than 4 corners, all in the same town and range, may be recorded on this certificate.**

A. Description of original monument and accessories and/or subsequent restoration:

I-3 GLO, March, 1832	LCRC L1-P171, Dec., 1971	LCRC L4-P345, Sept., 1982
Calvin Britain, D.S.	3/4" pipe	Set cast iron mon.
Set cor.	N 40 W 41.42' TP(V & spk.)	PP SW 38.78'
Black Ash 10 N 8 E 18	S 50 W 38.78' PP(Nail & Tag)	TP NW 41.17'
Black Ash 10 S 79 W 18	S 85 E 35.37' PP(Nail & Tag)	TP SE 35.37'
	E 3.0' C/L pav't. - 64th Ave.	C/L st. sign NE 32.40'

B. Description of corner evidence found and/or method applied in restoring or reestablishing corner:

I-3 Found Ottawa Co. Mon. (4" Harrison) down 1.2' in gravel rd.  
 PP SW 38.78'

And is accepted as a careful and faithful perpetuation of the position of the original corner.


PA. 345 OTTAWA COUNTY  
 PEER APPROVED 12/12/94  
*Madison D. Newbold*

C. Description of monument for corner and accessories established to perpetuate locating the position of the corner:

I-3 Ottawa Co. Mon. (4" Harrison) in gravel rd.  
 Nail & Ottawa Co. Remon. Tag in N side PP S 75 E 33.06'  
 Nail & Ottawa Co. Remon. Tag in W side 14" Maple N 25 E 81.44'  
 Nail & Ottawa Co. Remon. Tag in S side PP S 55 W 39.10'  
 Nail & Ottawa Co. Remon. Tag in top of wooden post N 40 W 46.08'  
 NW cor. hse. fnd. N 75 E 162.10'  
 On C/L gravel N & S, W

Signed by John C. Bueche  
 Surveyor's Michigan License No. 13027

Date 12-12-94

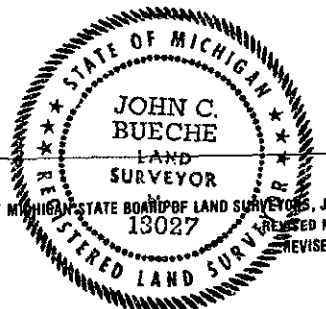

FORM APPROVED BY MICHIGAN STATE BOARD OF LAND SURVEYORS, JAN. 28, 1971  
 REVISED MAY 14, 1975  
 REVISED JAN., 1983