

**SURVEY &
REMONUMENTATION**

APR 05 1996

Ottawa County Remonumentation
LAND CORNER RECORDATION CERTIFICATE

COMMISSION Filing Requirement of Act 74, Mich. P.A. 1970

For corners in

<u>Ottawa</u> <small>(County)</small>	Located In:	Corner Code #
1. Public Land Survey	T <u>5N</u> R <u>14W</u>	<u>I-6 (E$\frac{1}{2}$, 15)</u>
	T _____ R _____	<u>Zeeland Twp.</u>
	T _____ R _____	_____
	T _____ R _____	_____
2. Property Controlling in Section	S _____ T _____ R _____	_____
	S _____ T _____ R _____	_____
3. Miscellaneous Property in Sec.	S _____ T _____ R _____	_____
	S _____ T _____ R _____	_____


RECORDED

95 NOV 29 PM 1:42

Elizabeth Robinson
REGISTER OF DEEDS
OTTAWA COUNTY, MI

Register of Deeds Stamp & File Number

4. Lot No. _____, Recorded Plat _____
5. Private Claims _____

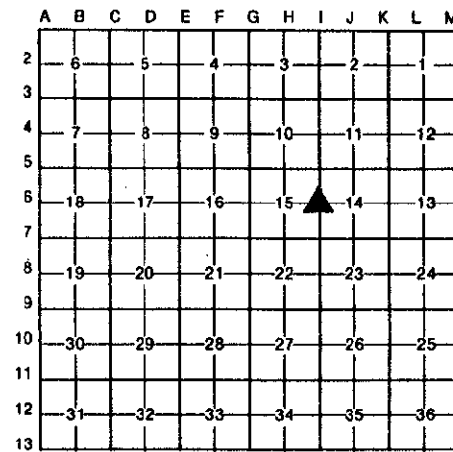

I, John C. Bueche, in a field survey on November 13, 19 95, do hereby certify that under requirements of P.A. 74, Michigan P.A. of 1970, the corner points mentioned in lines 1 and 2 above were in conformance with regulations and rules therefore as required in the current manual of survey instructions of the United States Department of the Interior, Bureau of Land Management or by a decree of a Court of Law and/or that the corner points mentioned in lines 3, 4 and 5 above were in conformance with the rules of the Michigan Board of Land Surveyors or by a Decree of a Court of Law; established, re-established, monumented, re-monumented, recovered, found as expressed below:

NOTE: Not more than 4 corners, all in the same town and range, may be recorded on this certificate.

A. Description of original monument and accessories and/or subsequent restoration:

I-6 GLO Calvin Britain, D.S. March, 1832	LCRC L1-P351, April, 1972 Set T iron halfway & on line between section cors. Nail in face of TP S 85 E 32.71' Nail in face of PP NW 50.43'	LCRC L5-P171 Dec., 1984 found Set cast iron mon. 3/4" pipe NE 46.53 1/2" bar SE 45.56 PK's W of C/L rd. NW 8.14 PK's W of C/L rd. SW 7.71
Set 1/2 mile post	Sugar 4 S 61 E 19 SE cor. Sec. 15 S 2645.23'	
	Sugar 7 N 25 W 17 NE cor. Sec. 15 N 2645.23'	

B. Description of corner evidence found and/or method applied in restoring or reestablishing corner:

I-6 Found cast iron mon. in Mon. Box
PK's W of C/L rd. NW 8.14'
PK's W of C/L rd. SW 7.71'

And is accepted as a careful and faithful perpetuation of the position of the original corner.

PA. 345 OTTAWA COUNTY
PEER APPROVED 11/20/95
Kudryk Redwood

C. Description of monument for corner and accessories established to perpetuate locating the position of the corner:

I-6 Cast iron mon. in Mon. Box
Set 1/2" rebar N 35 W 59.85'
Set 1/2" rebar S 35 E 76.25'
Set 1/2" rebar N 35 E 85.32'
Set 1/2" rebar S 35 W 76.40'
On C/L bit. N-S



Signed by John C. Bueche
John C. Bueche, P.S. 13027
Surveyor's Michigan License No. _____

Date Nov 16, 1995