

Ottawa County Remonumentation
LAND CORNER RECORDATION CERTIFICATE
Filing Requirement of Act 74, Mich. P.A. 1970

RECORDED

93 DEC 15 AM 9:31

Polina Holmwood
REGISTER OF DEEDS
OTTAWA COUNTY, MI

For corners in

Ottawa
(County)

Located In:

Corner Code #

1. Public Land Survey	T	<u>5N</u>	R	<u>14W</u>	<u>I-7 (SE, 15)</u>
	T		R		<u>Zeeland Twp.</u>
	T		R		
	T		R		
2. Property Controlling in Section	S		T	R	
	S		T	R	
3. Miscellaneous Property in Sec.	S		T	R	
	S		T	R	

Register of Deeds Stamp & File Number

4. Lot No. _____, Recorded Plat _____
5. Private Claims _____

I, John C. Bueche, in a field survey on November 29, 1993, do hereby certify that under requirements of P.A. 74, Michigan P.A. of 1970, the corner points mentioned in lines 1 and 2 above were in conformance with regulations and rules therefore as required in the current manual of survey instructions of the United States Department of the Interior, Bureau of Land Management or by a decree of a Court of Law and/or that the corner points mentioned in lines 3, 4 and 5 above were in conformance with the rules of the Michigan Board of Land Surveyors or by a Decree of a Court of Law; established, re-established, monumented, re-monumented, recovered, found as expressed below:

NOTE: Not more than 4 corners, all in the same town and range, may be recorded on this certificate.

A. Description of original monument and accessories and/or subsequent restoration:

I-7 LCRC (L1, P287)
March 8, 1972
Found 3/4" lead filled pipe
Nail in face TP
N 30° E 36.84'
Nail in face PP
S 50° E 31.00'
Nail in face TP
N 40° W 36.16'

I-7 LCRC (L2, P549)
Sept. 9, 1974
Found iron NW cor. brick
sta. SE 59.55'
PP SE 31.00'
TP NE 36.92'
TP NW 36.15'
C/L bit. conc.
dave N 4.2'

I-7 LCRC (L2, P671)
Oct. 21, 1974
Found round iron
PK in P & T pole SE 33.43'
PK in TP NE 37.11'
PK in P & T pole NW 36.35'


B. Description of corner evidence found and/or method applied in restoring or reestablishing corner:

I-7 Found O.C. Mon. in Mon. (2" Harrison) Box 3" below top Mon. Box,
1" below bit. PK in P & T pole SE 33.43'

And is accepted as a careful and faithful perpetuation of the position of the original corner.

C. Description of monument for corner and accessories established to perpetuate locating the position of the corner:

I-7 2" O.C. Mon. (Harrison) in Mon. Box, 3" down
Conc. Nail & O.C. Remon. Tag in NE side PP S 35° E 41.45'
SE cor. (back) of C.B. grate S 50° E 38.28'
SW cor. (back) of C.B. grate S 45° W 37.22'
SE cor. (front) of C.B. grate N 35° W 38.10'
NW cor. (front) of C.B. grate N 55° E 36.28'
C/L bit. N-S, E-W

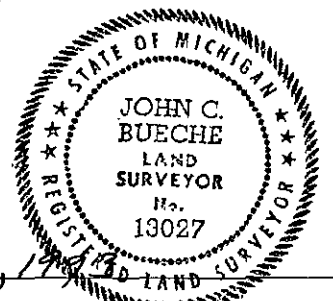

Signed by John C. Bueche
Surveyor's Michigan License No. 13027

Date Nov. 29, 1993