

1993

1993

COMMISSION

Ottawa County Remonumentation  
LAND CORNER RECORDATION CERTIFICATE  
Filing Requirement of Act 74, Mich. P.A. 1970

RECORDED

93 DEC 15 AM 9:31

*Phyllis Robinson*  
REGISTER OF DEEDS  
OTTAWA COUNTY, MI

For corners in  
Ottawa

(County)

Located In:

Corner Code #

1. Public Land Survey	T	5N	R	14W	I-9 (SE, 22)
	T		R		Zeeland Twp.
	T		R		
	T		R		
2. Property Controlling in Section	S		T	R	
	S		T	R	
3. Miscellaneous Property in Sec.	S		T	R	
	S		T	R	

Register of Deeds Stamp & File Number

4. Lot No. \_\_\_\_\_, Recorded Plat \_\_\_\_\_  
5. Private Claims \_\_\_\_\_

A	B	C	D	E	F	G	H	I	J	K	L	M
2	6	5	4	3	2							
3												
4	7	8	9	10	11	12						
5												
6	18	17	16	15	14	13						
7												
8	19	20	21	22	23	24						
9												
10	30	29	28	27	26	25						
11												
12	31	32	33	34	35	36						

I, John C. Bueche, in a field survey on November, 19 93, do hereby certify that under requirements of P.A. 74, Michigan P.A. of 1970, the corner points mentioned in lines 1 and 2 above were in conformance with regulations and rules therefore as required in the current manual of survey instructions of the United States Department of the Interior, Bureau of Land Management or by a decree of a Court of Law and/or that the corner points mentioned in lines 3, 4 and 5 above were in conformance with the rules of the Michigan Board of Land Surveyors or by a Decree of a Court of Law; established, re-established, monumented, re-monumented, recovered, found as expressed below:

NOTE: Not more than 4 corners, all in the same town and range, may be recorded on this certificate.

A. Description of original monument and accessories and/or subsequent restoration:

I-9 LCRC (L6, P7) Oct. 17, 1989  
Set C.I.M.  
PK in PP SW 72.12'  
PK in TP WSW 58.05'  
PK in PP SE 67.85'


B. Description of corner evidence found and/or method applied in restoring or reestablishing corner:

I-9 Found 4" O.C. Mon. (Harrison Mon.) in Mon. Box, 6" down from top of Mon. Box, Mon. Box flush with bit.  
PK in PP SW 72.12'  
PK in PP SE 67.85'

And is accepted as a careful and faithful perpetuation of the position of the original corner.

C. Description of monument for corner and accessories established to perpetuate locating the position of the corner:

I-9 O.C. Mon. (4" Harrison Mon.) in Mon. Box in bit. road  
Conc. Nail & O.C. Remon. Tag in W side PP S 45° W 72.16'  
Conc. Nail & O.C. Remon. Tag in S side PP S 45° E 67.67'  
Drill hole in N end of CMP (W pipe) N 50° W 42.50'  
Drill hole in E end of CMP (S pipe) N 20° E 95.17'  
C/L bit. N-S E 5.5'±  
C/L gravel road E, S 3'±  
On C/L gravel road W

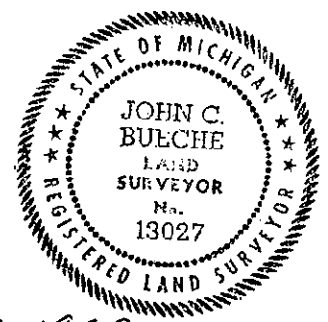

Signed by John C. Bueche  
Surveyor's Michigan License No. 13027

Date Nov. 29, 1993

L-9

Notes, no name or date

End. T iron

End. nail in SW side PP N 40° W 67.45'

C/L st. sign N 55° W 38.1'

C/L Perry S 3.5'

C/L 52nd to N, W 2.5'

Survey Nederveld, 1992

As wit. as on front