

1993

COMMISSION

Ottawa County Remonumentation
LAND CORNER RECORDATION CERTIFICATE
Filing Requirement of Act 74, Mich. P.A. 1970

RECORDED

93 DEC 15 AM 9:31

John C. Bueche
REGISTER OF DEEDS
OTTAWA COUNTY, MI

For corners in


Ottawa (County)	Located In:	Corner Code #
1. Public Land Survey	T <u>5N</u> R <u>14W</u>	<u>I-11 (SE, 27)</u> <u>Zeeland Twp.</u>
	T _____ R _____	_____
	T _____ R _____	_____
	T _____ R _____	_____
2. Property Controlling in Section	S _____ T _____ R _____	_____
	S _____ T _____ R _____	_____
3. Miscellaneous Property in Sec.	S _____ T _____ R _____	_____
	S _____ T _____ R _____	_____

Register of Deeds Stamp & File Number

4. Lot No. _____, Recorded Plat _____
5. Private Claims _____

I, John C. Bueche, in a field survey on October 13, 19 93, do hereby certify that under requirements of P.A. 74, Michigan P.A. of 1970, the corner points mentioned in lines 1 and 2 above were in conformance with regulations and rules therefore as required in the current manual of survey instructions of the United States Department of the Interior, Bureau of Land Management or by a decree of a Court of Law and/or that the corner points mentioned in lines 3, 4 and 5 above were in conformance with the rules of the Michigan Board of Land Surveyors or by a Decree of a Court of Law; established, re-established, monumented, re-monumented, recovered, found as expressed below:

NOTE: Not more than 4 corners, all in the same town and range, may be recorded on this certificate.

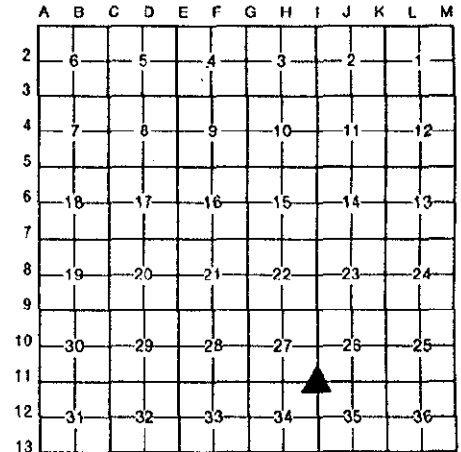

A. Description of original monument and accessories and/or subsequent restoration:

I-11 LCRC (L2, P739) Jan. 20, 1975	I-11 LCRC (L5, P84) Dec. 20, 1983
Found old fence post iron in mon. box	Set C.I.M.
Road sign N 45° E 35.45'	PP NE 37.77'
PP N 70° W 45.60'	PP NW 45.56'
NW cor. store SE 52.28'	TP SE 61.70'
	NW cor. conc. slab SE 44.55'


B. Description of corner evidence found and/or method applied in restoring or reestablishing corner:

I-11 Found capped iron #16042 H.E.I. in Mon. Box over broken O.C. Mon. (4" Harrison), down 8"	
NW cor. store SE 52.28'	PP NE 37.77'
	NW cor. conc. slab SE 44.55'
	PP NW 45.56'

And is accepted as a careful and faithful perpetuation of the position of the original corner.

C. Description of monument for corner and accessories established to perpetuate locating the position of the corner:

I-11 Set O.C. Cap in conc. over broken Mon.
O.C. Remon. Tag & Nail in SE side PP N 40° E 37.70'
SE cor. brick of fire barn @ ground N 45° W 80.87'
O.C. Remon. Tag & Nail in W side TP S 5° E 71.42'
NW cor. conc. slab S 40° E 44.50'
NW cor. old gas sta. (@ ground) S 43° W 88.07'
On C/L road N-S-E-W
Meas. by hand

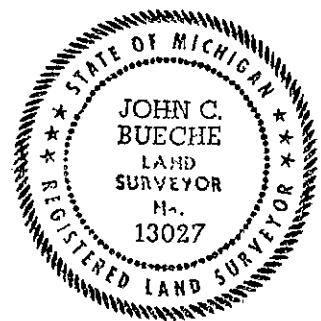

Signed by John C. Bueche Date Nov. 29, 1993
Surveyor's Michigan License No. 13027