

# SURVEY & REMONUMENTATION

APR 25 1995

COMMISSION

Ottawa County Remonumentation  
LAND CORNER RECORDATION CERTIFICATE  
Filing Requirement of Act 74, Mich. P.A. 1970

RECORDED

94 DEC -8 PM 12:38

*Phyllis Robinson*  
REGISTER OF DEEDS  
OTTAWA COUNTY, MI

3 or corners in

<u>Ottawa</u>	Located In:	Corner Code #	
(County)			
Public Land Survey	T <u>5N</u> R <u>14W</u>	K-9 (SE, 23)	<u>Zeeland Twp.</u>
	T _____ R _____	_____	_____
	T _____ R _____	_____	_____
	T _____ R _____	_____	_____
Property Controlling in Section	S _____ T _____ R _____	_____	_____
Miscellaneous	S _____ T _____ R _____	_____	_____
Property in Sec.	S _____ T _____ R _____	_____	_____

Register of Deeds Stamp & File Number

Lot No. \_\_\_\_\_, Recorded Plat \_\_\_\_\_  
Private Claims \_\_\_\_\_

John C. Bueche, in a field survey on October 12, 19 94,  
hereby certify that under requirements of P.A. 74, Michigan P.A. of 1970, the corner points mentioned in lines 1 and 2 above were in conformance with regulations and rules therefore as required in the current manual of survey instructions of the United States Department of the Interior, Bureau of Land Management or by a decree of a Court of Law and/or that the corner points mentioned in lines 3, 4 and 5 above were in conformance with the rules of the Michigan Board of Land Surveyors or by a Decree of a Court of Law; established, re-established, monumented, re-monumented, recovered, found as pressed below:

	A	B	C	D	E	F	G	H	I	J	K	L	M
2	6	5	4	3	2	1							
3													
4	7	8	9	10	11	12							
5													
6	18	17	16	15	14	13							
7													
8	19	20	21	22	23	24							
9													
10	30	29	28	27	26	25							
11													
12	31	32	33	34	35	36							
13													

**NOTE: Not more than 4 corners, all in the same town and range, may be recorded on this certificate.**

Description of original monument and accessories and/or subsequent restoration:

K-9 GLO March, 1832	LCRC L5-P347
Calvin Britain, D.S.	CIM, Dec., 1988
Set	Face of st. sign SE 34.48'
Lynn 10 N 73 E 10	PP WSW 94.66'
Beech 10 S 65 W 8	1/2" rod NE 30.00'
	1/2" rod NW 35.00'

Description of corner evidence found and/or method applied in restoring or reestablishing corner:

K-9 Found Ottawa Co. Mon. (2" Harrison) in Mon. Box  
Mon. is broken, C/L on Mon. is 0.05' W of E edge inside of box  
PP WSW 94.66'

And is accepted as a careful and faithful perpetuation of the position of the original corner.

P.A. 345 OTTAWA COUNTY  
PEER APPROVED 11/21/94


*Madon D. Redwood*

Description of monument for corner and accessories established to perpetuate locating the position of the corner:

K-9 Ottawa Co. Mon. (broken 2" Mon.) C/L of broken Mon. is 0.05' W of E edge inside edge of box

Nail & Ottawa Co. Remon. Tag in S side PP	S 75 W 94.83'
Nail & Ottawa Co. Remon. Tag in E side PP	S 05 E 242.72'
Nail & Ottawa Co. Remon. Tag in SW side PP	N 20 W 73.53'
Nail & Ottawa Co. Remon. Tag in SE side PP	N 45 E 46.19'
NW cor. of hse. fnd.	S 40 W 179.54'

On C/L gravel rd. to W  
On C/L N-S bit. rd.  
C/L gravel rd. E is S 2.5' ±

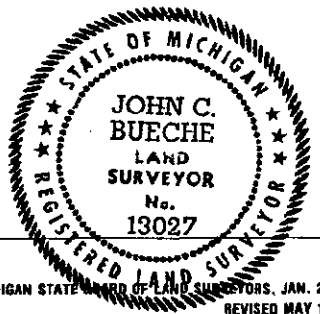

Signed by John C. Bueche  
Surveyor's Michigan License No. 13027

Date 11-18-94