

**SURVEY &
REMONUMENTATION**

APR 25 1995

COMMISSION

Ottawa County Remonumentation
LAND CORNER RECORDATION CERTIFICATE
Filing Requirement of Act 74, Mich. P.A. 1970

RECORDED

94 DEC -8 PM 12:38

Phyllis Redman
REGISTER OF DEEDS
OTTAWA COUNTY, MI

or corners in

Ottawa

(County)

Located In:

Corner Code #

Public Land Survey	T	<u>5N</u>	R	<u>14W</u>	K-11 (SE, 26)
	T		R		<u>Zeeland Twp.</u>
	T		R		
	T		R		
Property Controlling in Section	S		T		
Miscellaneous	S		T		
Property in Sec.	S		T		

Register of Deeds Stamp & File Number

Lot No. _____, Recorded Plat _____
Private Claims _____

A	B	C	D	E	F	G	H	I	J	K	L	M
2	6	5	4	3	2	1						
3												
4	7	8	9	10	11	12						
5												
6	18	17	16	15	14	13						
7												
8	19	20	21	22	23	24						
9												
10	30	29	28	27	26	25						
11												
12	31	32	33	34	35	36						
13												

John C. Bueche, in a field survey on October 12, 19 94,
I hereby certify that under requirements of P.A. 74, Michigan P.A. of 1970, the corner points mentioned
lines 1 and 2 above were in conformance with regulations and rules therefore as required in the
current manual of survey instructions of the United States Department of the Interior, Bureau of Land
Management or by a decree of a Court of Law and/or that the corner points mentioned in lines 3, 4 and 5
above were in conformance with the rules of the Michigan Board of Land Surveyors or by a Decree of a
Court of Law; established, re-established, monumented, re-monumented, recovered, found as
expressed below:

**NOTE: Not more than 4 corners, all in the same town and range, may be recorded
on this certificate.**

Description of original monument and accessories and/or subsequent restoration:

K-11 GLO March, 1832	LCRC L3-P72 Mon. Box in C/L bit.	LCRC L5-P83 CIM, Dec., 1983
Calvin Britain, D.S.	April, 1972 Rd. sign S 45 E 36.08'	PP NW 61.24' TP SW 41.83'
Set cor.	TP S 45 W 41.90'	St. sign 41.63'
Sugar 20 N 25 W 14	PP N 20 W 61.19'	Gas line marker NE 35.87'

Description of corner evidence found and/or method applied in restoring or reestablishing corner:

K-11 Ottawa Co. Mon. (2" Harrison) in Mon. Box, no cover
No wit. left No wit. left
Accepted as corner

And is accepted as a careful and faithful perpetuation of the position
of the original corner.

P.A. 345 OTTAWA COUNTY
PEER APPROVED 11/21/94


Madison D. Nedewell

Description of monument for corner and accessories established to perpetuate locating the position of the corner:

K-11 Ottawa Co. Mon. (2" Harrison) in Mon. Box	
NE face of fence post	S 45 E 48.39'
Nail & Ottawa Co. Remon. Tag in N side PP	N 25 W 67.73'
Nail & Ottawa Co. Remon. Tag in N side 32" Maple	N 80 W 163.09'
Nail & Ottawa Co. Remon. Tag in S side 3-18" Maples	N 70 W 116.76'
C/L MH	S 35 W 48.09'
On C/L bit. rd. N-S, E-W	

Signed by John C. Bueche
Surveyor's Michigan License No. 13027

Date 11-18-94

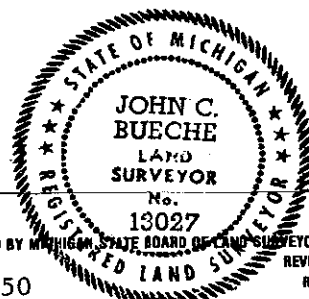

FORM APPROVED BY MICHIGAN STATE BOARD OF LAND SURVEYORS, JAN. 28, 1971
REVISED MAY 14, 1975
REVISED JAN., 1983