

**Ottawa County Remonumentation  
LAND CORNER RECORDATION CERTIFICATE  
Filing Requirement of Act 74, Mich. P.A. 1970**

For corners in

Ottawa  
(County)

Located In:

Corner Code #

- |                                    |                          |                         |
|------------------------------------|--------------------------|-------------------------|
| 1. Public Land Survey              | T <u>5N</u> R <u>14W</u> | <u>K-12 (E 1/4, 35)</u> |
|                                    | T _____ R _____          | <u>Zeeland Twp.</u>     |
|                                    | T _____ R _____          | _____                   |
|                                    | T _____ R _____          | _____                   |
| 2. Property Controlling in Section | S _____ T _____ R _____  | _____                   |
|                                    | S _____ T _____ R _____  | _____                   |
| 3. Miscellaneous Property in Sec.  | S _____ T _____ R _____  | _____                   |
|                                    | S _____ T _____ R _____  | _____                   |

RECORDED

96 DEC 17 AM 10:43

*D. J. ...*  
REGISTER OF DEEDS  
OTTAWA COUNTY, MI

Register of Deeds Stamp & File Number

4. Lot No. \_\_\_\_\_, Recorded Plat \_\_\_\_\_  
5. Private Claims \_\_\_\_\_

	A	B	C	D	E	F	G	H	I	J	K	L	M
2	6	5	4	3	2	1							
3													
4	7	8	9	10	11	12							
5													
6	18	17	16	15	14	13							
7													
8	19	20	21	22	23	24							
9													
10	30	29	28	27	26	25							
11													
12	31	32	33	34	35	36							
13													

I, John C. Bueche, in a field survey on October 30, 19 96, do hereby certify that under requirements of P.A. 74, Michigan P.A. of 1970, the corner points mentioned in lines 1 and 2 above were in conformance with regulations and rules therefore as required in the current manual of survey instructions of the United States Department of the Interior, Bureau of Land Management or by a decree of a Court of Law and/or that the corner points mentioned in lines 3, 4 and 5 above were in conformance with the rules of the Michigan Board of Land Surveyors or by a Decree of a Court of Law; established, re-established, monumented, re-monumented, recovered, found as expressed below:

**NOTE: Not more than 4 corners, all in the same town and range, may be recorded on this certificate.**

A. Description of original monument and accessories and/or subsequent restoration:

K-12 GLO	LCRC L3, P78	LCRC L3, P72
Set 1/2 mile post	April 7, 1976 T iron	April 6, 1979 T iron
Beech 10 S 21 E 22	20" Cherry SSE 131.90'	24" W. Cherry S 10° E 131.95'
Beech 8 N 70 W 20	10" Ash NNE 192.15'	Rd. sign S 85° E 21.54'
Calvin Britain	C/L st. sign E 21.6'	N end culvt. N 45° W 21.40'
March, 1832	Survey L2, P829 same wit.	S end culvt. S 45° W 22.76'

OVER

B. Description of corner evidence found and/or method applied in restoring or reestablishing corner:

K-12 Found Mon. box, nothing in box (held C/L Mon. box)  
On C/L bit. N-S  
Field division West  
Meas. N to NE 35 2652.88'      Angle S-W-N 180° 01' 00"  
Meas. S to SE 35 2642.83'      All wit. gone

And is accepted as a careful and faithful perpetuation of the position of the original corner.


P.A. 345 OTTAWA COUNTY  
PEER APPROVED 11-11-96

*J. D. N.*

C. Description of monument for corner and accessories established to perpetuate locating the position of the corner:

K-12 Set Ottawa Co. Mon. (3/4" x 24" pin with cap) in C/L of Mon. box  
X cut on N end conc. pipe N 60° W 28.08'  
X cut on S end conc. pipe S 50° W 31.03'  
C/L post on N side of gate S 50° E 45.66'  
C/L 5 post N of gate N 60° E 38.22'  
On C/L bit. N-S  
On field division West

\$ 11.00 CORNER  
\$ 1.00 PHOTO  
\$ 1.00 BEARS

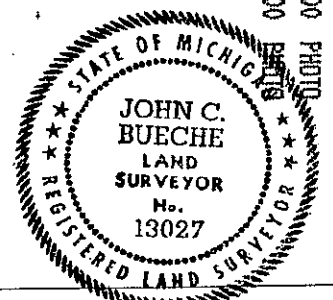

Signed by John C. Bueche  
John C. Bueche, P.S.

Date 11-7-96

Surveyor's Michigan License No. 13027

K-12

CP S to SE 35 2641.68'

CP N to NE 35 2652.69'

Straight line

Holland Eng. S to SE 35 2642.92'

Holland Eng. N to NE 35 2653.06'

Angle S-W-N 180° 01' 56"