

SURVEY & MONUMENTATION

APR 05 1996
COMMISSION

Ottawa County Remonumentation
LAND CORNER RECORDATION CERTIFICATE
Filing Requirement of Act 74, Mich. P.A. 1970

RECORDED

95 DEC 12 PM 4:51

For corners in
Ottawa
(County)

Located In: Corner Code #

- | | | | | | |
|------------------------------------|---|----|---|-----|----------------------------|
| 1. Public Land Survey | T | 5N | R | 14W | L-5 (S $\frac{1}{4}$, 12) |
| | T | | R | | Zeeland Twp. |
| | T | | R | | |
| | T | | R | | |
| 2. Property Controlling in Section | S | | T | R | |
| | S | | T | R | |
| 3. Miscellaneous Property in Sec. | S | | T | R | |
| | S | | T | R | |

Phyllis Kallman
REGISTER OF DEEDS
OTTAWA COUNTY, MI

Register of Deeds Stamp & File Number

4. Lot No. _____, Recorded Plat _____
5. Private Claims _____

I, John C. Bueche, in a field survey on November 30, 19 95, do hereby certify that under requirements of P.A. 74, Michigan P.A. of 1970, the corner points mentioned in lines 1 and 2 above were in conformance with regulations and rules therefore as required in the current manual of survey instructions of the United States Department of the Interior, Bureau of Land Management or by a decree of a Court of Law and/or that the corner points mentioned in lines 3, 4 and 5 above were in conformance with the rules of the Michigan Board of Land Surveyors or by a Decree of a Court of Law; established, re-established, monumented, re-monumented, recovered, found as expressed below:

A	B	C	D	E	F	G	H	I	J	K	L	M
2	6	5	4	3	2	1						
3												
4	7	8	9	10	11	12						
5												
6	18	17	16	15	14	13						
7												
8	19	20	21	22	23	24						
9												
10	30	29	28	27	26	25						
11												
12	31	32	33	34	35	36						
13												

NOTE: Not more than 4 corners, all in the same town and range, may be recorded on this certificate.

A. Description of original monument and accessories and/or subsequent restoration:

L-5 GLO	LCRC L1-P459	
Calvin Britain, D.S.	June, 1972	
April, 1832	Nail in face of TP	NE 44.50'
40.00' set 1/4 post on line	Nail in face of PP	S 94.24'
Beech 10 S 40 W 14	Nail in face of TP	WNW 102.14'
Beech 10 N 62 E 21	Nail in side of fence post	WSW 36.40'
	C/L street sign post	SSE 23.87'

B. Description of corner evidence found and/or method applied in restoring or reestablishing corner:

L-5 Found 1" iron
Nail in face of TP WNW 102.14'
Nail in side of fence post WSW 36.40'
Nail in face of PP S 94.24'

And is accepted as a careful and faithful perpetuation of the position of the original corner.

P.A. 345 OTTAWA COUNTY

PEER APPROVED 12/11/95


Wesley P. Hedewell
JD

C. Description of monument for corner and accessories established to perpetuate locating the position of the corner:

L-5 Replaced 1" iron with 3/4" x 24" Pin with Ottawa Co. Cap
Set Nail & Ottawa Co. Remon. Tag in SW side TP N 75 W 101.39'
Set Nail & Ottawa Co. Remon. Tag in E side 14" Maple S 00 W 24.73'
Set Nail & Ottawa Co. Remon. Tag in NW side 8" Maple S 70 W 46.55'
SE cor. block bldg. N 40 W 89.60'
C/L gravel rd. N, E 5'±
On C/L gravel rd. E-W

Signed by John C. Bueche
John C. Bueche, P.S. 13027
Surveyor's Michigan License No. _____

Date 12-6-95

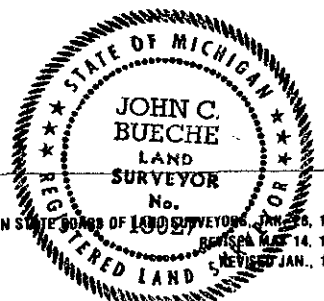

FORM APPROVED BY MICHIGAN STATE BOARD OF LAND SURVEYORS, JAN. 25, 1971
REVISED MAR. 14, 1975
REVISED JAN., 1983