

**Ottawa County Remonumentation
LAND CORNER RECORDATION CERTIFICATE
Filing Requirement of Act 74, Mich. P.A. 1970**

For corners in

<u>Ottawa</u> (County)	Located in:	Corner Code #
1. Public Land Survey	T <u>5N</u> R <u>14W</u>	<u>L-9 (S 1/4, 24)</u> <u>Zeeland Twp.</u>
	T _____ R _____	_____
	T _____ R _____	_____
	T _____ R _____	_____
2. Property Controlling in Section	S _____ T _____ R _____	_____
	S _____ T _____ R _____	_____
3. Miscellaneous Property in Sec.	S _____ T _____ R _____	_____
	S _____ T _____ R _____	_____

RECORDED

96 DEC 17 AM 10:43

Polycarpus Williams
REGISTER OF DEEDS
OTTAWA COUNTY, MI

Register of Deeds Stamp & File Number

4. Lot No. _____, Recorded Plat _____
5. Private Claims _____

A	B	C	D	E	F	G	H	I	J	K	L	M
2	6	5	4	3	2	1						
3												
4	7	8	9	10	11	12						
5												
6	18	17	16	15	14	13						
7												
8	19	20	21	22	23	24						
9												
10	30	29	28	27	26	25						
11												
12	31	32	33	34	35	36						
13												

I, John C. Bueche, in a field survey on October 30, 19 96, do hereby certify that under requirements of P.A. 74, Michigan P.A. of 1970, the corner points mentioned in lines 1 and 2 above were in conformance with regulations and rules therefore as required in the current manual of survey instructions of the United States Department of the Interior, Bureau of Land Management or by a decree of a Court of Law and/or that the corner points mentioned in lines 3, 4 and 5 above were in conformance with the rules of the Michigan Board of Land Surveyors or by a Decree of a Court of Law; established, re-established, monumented, re-monumented, recovered, found as expressed below:

NOTE: Not more than 4 corners, all in the same town and range, may be recorded on this certificate.

A. Description of original monument and accessories and/or subsequent restoration:

L-9 GLO Calvin Britain, DS, 1832 1/4 Sec. post on true line Beech 12 S 60 E 5 Beech 20 North 20	Ottawa Co. Surveyors Records Foster, no date Stone	CP Co. Set iron on C/L rd. N & 4' N of C/L E-W rd. PP NW 66.98' TP ESE 120.18' St. sign SSW 26.85' S 1/4 to C 1/4 2646.70' S 1/4 to SW 2632.00' OVER
---	---	--

B. Description of corner evidence found and/or method applied in restoring or reestablishing corner:

L-9 Found T iron, down 1'±

As per wit. on back of this sheet

And is accepted as a careful and faithful perpetuation of the position of the original corner.


P.A. 345 OTTAWA COUNTY
PEER APPROVED 11-11-96

J.P.N.

C. Description of monument for corner and accessories established to perpetuate locating the position of the corner:

L-9 Replaced T iron with Ottawa Co. Mon. (3/4" x 24" pin with cap)
X cut on top W end conc. culvt. S 33° W 24.96'
X cut on top E end conc. culvt. S 40° E 27.34'
Nail & Ottawa Co. Remon. Tag in E side PP N 30° E 66.74'
Nail & Ottawa Co. Remon. Tag in W side PP N 20° W 67.43'
On C/L gravel N; C/L gravel rd. E-W, S 3.5'±
On field division South

\$ 11.00 CORNER
\$ 1.00 PHOTO

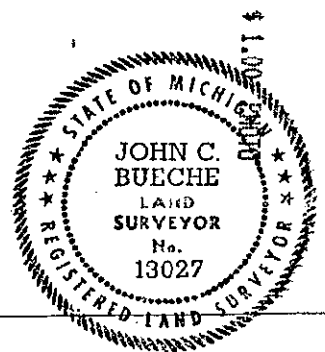

Signed by John C. Bueche
John C. Bueche, P.S. 13027
Surveyor's Michigan License No. _____

Date 11-7-96