

SURVEY & REMONUMENTATION

APR 25 1995

COMMISSION

**Ottawa County Remonumentation
LAND CORNER RECORDATION CERTIFICATE**

RECORDED

DEC - 8 PM 12:38

Filing Requirement of Act 74, Mich. P.A. 1970

For corners in

Ottawa
(County)

Located In:

Corner Code #

- | | | |
|---------------------------------------|--------------------------|---|
| 1. Public Land Survey | T <u>5N</u> R <u>14W</u> | <u>L-11 (N$\frac{1}{2}$, 36)</u> |
| | T _____ R _____ | <u>Zeeland Twp.</u> |
| | T _____ R _____ | _____ |
| | T _____ R _____ | _____ |
| 2. Property Controlling in Section | S _____ T _____ R _____ | _____ |
| | S _____ T _____ R _____ | _____ |
| 3. Miscellaneous Property in Sec. | S _____ T _____ R _____ | _____ |
| | S _____ T _____ R _____ | _____ |
| 4. Lot No. _____, Recorded Plat _____ | | |
| 5. Private Claims _____ | | |

John C. Bueche
REGISTER OF DEEDS
OTTAWA COUNTY, MI

Register of Deeds Stamp & File Number

I, John C. Bueche, in a field survey on October 14, 19 94, do hereby certify that under requirements of P.A. 74, Michigan P.A. of 1970, the corner points mentioned in lines 1 and 2 above were in conformance with regulations and rules therefore as required in the current manual of survey instructions of the United States Department of the Interior, Bureau of Land Management or by a decree of a Court of Law and/or that the corner points mentioned in lines 3, 4 and 5 above were in conformance with the rules of the Michigan Board of Land Surveyors or by a Decree of a Court of Law; established, re-established, monumented, re-monumented, recovered, found as expressed below:

NOTE: Not more than 4 corners, all in the same town and range, may be recorded on this certificate.

	A	B	C	D	E	F	G	H	I	J	K	L	M
2	6	5	4	3	2	1							
3													
4	7	8	9	10	11	12							
5													
6	18	17	16	15	14	13							
7													
8	19	20	21	22	23	24							
9													
10	30	29	28	27	26	25							
11													
12	31	32	33	34	35	36							
13													

A. Description of original monument and accessories and/or subsequent restoration:


L-11 GLO March, 1832	LCRC L3-P72, April, 1976	LCRC L5-P83
Calvin Britain, D.S.	1" iron in Mon. Box	CIM, Dec., 1983
Set post Beech 8	1' N of C/L bit.	23" B. Cherry NNW 32.14'
S 74 E 4	TP S 10 W 33.63'	25" B. Cherry NW 42.69'
Sugar 18	28" W. Cherry N 25 W 32.15'	24" Maple S 48.18'
S 76 W 12	PP N 5 W 45.03'	25" Catalpa SW 63.44'

B. Description of corner evidence found and/or method applied in restoring or reestablishing corner:

L-11 Found broken Ottawa Co. Mon. in Mon. Box (2" Harrison) down 6" in box, no cover
28" W. Cherry N 25 W 32.15' As per wbove wit.

And is accepted as a careful and faithful perpetuation of the position of the original corner.

PA. 345 OTTAWA COUNTY
PEER APPROVED 11/21/94

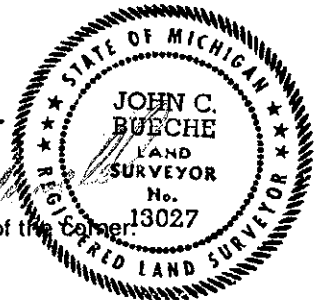

C. Description of monument for corner and accessories established to perpetuate the position of the corner:

L-11 Ottawa Co. Mon. (2" Harrison) broken in Mon. Box
Nail & Ottawa Co. Remon. Tag in W side 26" Maple S 15 W 48.25'
Nail & Ottawa Co. Remon. Tag in E side 32" Catalpa S 50 W 63.61'
Nail & Ottawa Co. Remon. Tag in SW side 32" W. Cherry N 50 W 42.32'
Nail & Ottawa Co. Remon. Tag in E side PP N 00 E 43.65'
C/L bit. E-S, S 1'±
On tree line N

Signed by John C. Bueche
John C. Bueche
Surveyor's Michigan License No. 13027

Date 11-18-94