

**Ottawa County Remonumentation
LAND CORNER RECORDATION CERTIFICATE
Filing Requirement of Act 74, Mich. P.A. 1970**

RECORDED

97 JUL 24 PM 2: 25

For corners in
Ottawa
(County)

Located In: Corner Code #

1. Public Land Survey	T <u>5N</u> R <u>14W</u>	<u>M-2 (E$\frac{1}{2}$, 1)</u>
	T _____ R _____	<u>Zeeland Twp.</u>
	T _____ R _____	_____
	T _____ R _____	_____
2. Property Controlling in Section	S _____ T _____ R _____	_____
	S _____ T _____ R _____	_____
3. Miscellaneous Property in Sec.	S _____ T _____ R _____	_____
	S _____ T _____ R _____	_____

Edythe Robinson
REGISTER OF DEEDS
OTTAWA COUNTY, MI

Register of Deeds Stamp & File Number

4. Lot No. _____, Recorded Plat _____
5. Private Claims _____

	A	B	C	D	E	F	G	H	I	J	K	L	M
2	6	5	4	3	2								
3													
4	7	8	9	10	11	12							
5													
6	18	17	16	15	14	13							
7													
8	19	20	21	22	23	24							
9													
10	30	29	28	27	26	25							
11													
12	31	32	33	34	35	36							
13													

I, John C. Bueche, in a field survey on April 1, 19 97, do hereby certify that under requirements of P.A. 74, Michigan P.A. of 1970, the corner points mentioned in lines 1 and 2 above were in conformance with regulations and rules therefore as required in the current manual of survey instructions of the United States Department of the Interior, Bureau of Land Management or by a decree of a Court of Law and/or that the corner points mentioned in lines 3, 4 and 5 above were in conformance with the rules of the Michigan Board of Land Surveyors or by a Decree of a Court of Law; established, re-established, monumented, re-monumented, recovered, found as expressed below:

NOTE: Not more than 4 corners, all in the same town and range, may be recorded on this certificate.

A. Description of original monument and accessories and/or subsequent restoration:

M-2	LCRC L3, P3	LCRC L4, P342
GLO Nov., 1831	Solid iron Dec., 1975	Set cast iron mon. Sept., 1982
Lucius Lyon, DS	30" Maple NW 28.36'	PP W 49.74'
Set HMP	PP W 49.65'	24" Ash NNE 69.42'
Sugar 24 S 25 W 43	Tw. 24" Oak ESE 57.97'	6" Tree W 25.65'
Sugar 5 N 54 W 28		St. sign SSW 59.40'

OVER P.A. 345 OTTAWA COUNTY
PEER APPROVED 4/21/97
N.D.N.

B. Description of corner evidence found and/or method applied in restoring or reestablishing corner:


M-2 Found Ottawa Co. Mon. (alum. cap)	PP W 49.65'	PP W 49.74'	Nail & Tag in W side guard post
		24" Ash NNE 69.42'	S 5° E 91.37'
		6" Tree W 25.65'	Nail & Tag in E side PP S 35°
		St. sign SSW 59.40'	W 153.00'
And is accepted as a careful and faithful perpetuation of the position of the original corner.			Nail & Tag in W side 30" Oak N 10°
			E 69.62'
			Nail & Tag in E face Tree N 80° W 25.
			PK Nail in blacktop dr. S 65° W 63.73
			Rerod in Mon. Box S (W 1/4 Sec. 6, 5-13) 47.53'

C. Description of monument for corner and accessories established to perpetuate locating the position of the corner:

M-2 Ottawa Co. Mon. in Mon. Box with alum. cap
Nail & Tag in W side guard post S 5° E 91.37'
Nail & Tag in E side PP S 35° W 153.00'
Ottawa Co. Remon. Tag & Nail in N side 12" Box Elder N 80° W 25.71'
Nail & Tag in E face Tree N 80° W 25.18'
PK Nail in blacktop dr. S 65° W 63.73'
Rerod in Mon. Box S (W 1/4 Sec. 6, 5-13) 47.53'
C/L bit. N-S, West 2'±, C/L gravel rd. E, South 45'±

4 11.00 CORNER

Signed by John C. Bueche, P.S. Date 4-16-97
Surveyor's Michigan License No. 13027

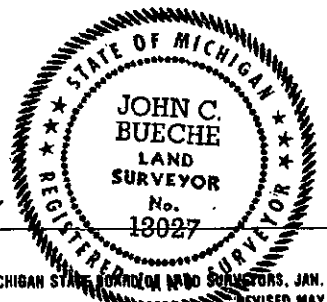

PART A - continued

LCRC L6, P21

Capped iron in Mon. Box, Dec., 1989

Nail & Tag in W side guard post S 5° E 91.37'

Nail & Tag in E side PP S 35° W 153.00'

Nail & Tag in W side 30" Oak N 10° E 69.62'

Nail & Tag in E face Tree N 80° W 25.18'

PK Nail in blacktop dr. S 65° W 63.73'

Rerod in Mon. Box S (W 1/4 Sec. 6, 5-13) 47.53'