

**SURVEY &  
REMONUMENTATION**

APR 24 1995

**COMMISSION**

For corners in

Ottawa

(County)

Located In:

Corner Code #

1. Public Land Survey	T	<u>5N</u>	R	<u>14W</u>	<u>M-3 (SE, 1)</u>	
	T	_____	R	_____	<u>Zeeland Twp.</u>	
	T	_____	R	_____	_____	
	T	_____	R	_____	_____	
2. Property Controlling In Section	S	_____	T	_____	R	_____
	S	_____	T	_____	R	_____
3. Miscellaneous Property in Sec.	S	_____	T	_____	R	_____
	S	_____	T	_____	R	_____

RECORDED

94 DEC 15 AM 11:48

*Dorothy C. Hollman*  
REGISTER OF DEEDS  
OTTAWA COUNTY, MI

Register of Deeds Stamp & File Number

4. Lot No. \_\_\_\_\_, Recorded Plat \_\_\_\_\_  
5. Private Claims \_\_\_\_\_

	A	B	C	D	E	F	G	H	I	J	K	L	M
2	6	5	4	3	2	1							
3													
4	7	8	9	10	11	12							
5													
6	18	17	16	15	14	13							
7													
8	19	20	21	22	23	24							
9													
10	30	29	28	27	26	25							
11													
12	31	32	33	34	35	36							
13													

I, John C. Bueche, in a field survey on December 6, 19 94, do hereby certify that under requirements of P.A. 74, Michigan P.A. of 1970, the corner points mentioned in lines 1 and 2 above were in conformance with regulations and rules therefore as required in the current manual of survey instructions of the United States Department of the Interior, Bureau of Land Management or by a decree of a Court of Law and/or that the corner points mentioned in lines 3, 4 and 5 above were in conformance with the rules of the Michigan Board of Land Surveyors or by a Decree of a Court of Law; established, re-established, monumented, re-monumented, recovered, found as expressed below:

**NOTE: Not more than 4 corners, all in the same town and range, may be recorded on this certificate.**

A. Description of original monument and accessories and/or subsequent restoration:

M-3 GLO, March, 1832	LCRC L3-P3
Calvin Britain, D.S.	Iron, Dec., 1975
Set post cor. sec.	Iron S 49.55'
Beech 20 N 18 W 14	30" Maple ESE 75.60'
Sugar 12 S 20 W 49	16" Basswood NNE 59.90'
	40" Maple NNW 66.20'

B. Description of corner evidence found and/or method applied in restoring or reestablishing corner:

M-3 Found iron down 8" in bit. rd.

Iron	S 49.55'
30" Maple	ESE 75.60'

And is accepted as a careful and faithful perpetuation of the position of the original corner.

P.A. 345 OTTAWA COUNTY  
PEER APPROVED 12/12/94  
*Harold D. Nedewell*


C. Description of monument for corner and accessories established to perpetuate locating the position of the corner:

M-3 Replaced iron with Ottawa Co. Mon. (3/4" x 24" Pin with Alum. Cap) in Mon. Box

Nail & Ottawa Co. Remon. Tag in NE side 18" Maple	N 55 W 76.76'
Nail & Ottawa Co. Remon. Tag in N side 12" Oak	S 50 W 61.71'
Nail & Ottawa Co. Remon. Tag in E side 10" Ash	S 20 E 75.50'
PK & Nail in N side 38" Maple	S 70 E 75.60'
On C/L bit. N-S, on C/L gravel W	
Jamestown cor., capped iron	S 49.55'

Signed by John C. Bueche  
Surveyor's Michigan License No. 3027

Date 12-12-94

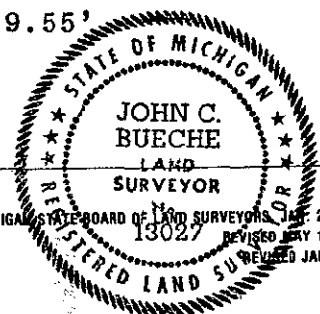

FORM APPROVED BY MICHIGAN BOARD OF LAND SURVEYORS, MAY 28, 197  
REVISED JULY 14, 197  
REVISED JAN., 198