

**Ottawa County Remonumentation  
LAND CORNER RECORDATION CERTIFICATE  
Filing Requirement of Act 74, Mich. P.A. 1970**

For corners in

Ottawa

(County)

Located In:

Corner Code #

- |                                    |                          |                      |
|------------------------------------|--------------------------|----------------------|
| 1. Public Land Survey              | T <u>5N</u> R <u>14W</u> | <u>M-6 (E 1, 13)</u> |
|                                    | T ___ R ___              | <u>Zeeland Twp.</u>  |
|                                    | T ___ R ___              | _____                |
|                                    | T ___ R ___              | _____                |
| 2. Property Controlling in Section | S ___ T ___ R ___        | _____                |
|                                    | S ___ T ___ R ___        | _____                |
| 3. Miscellaneous Property in Sec.  | S ___ T ___ R ___        | _____                |
|                                    | S ___ T ___ R ___        | _____                |

**RECORDED**

96 DEC 17 AM 10:41

*leg 1*

*John C. Bueche*  
REGISTER OF DEEDS  
OTTAWA COUNTY, MI

Register of Deeds Stamp & File Number

4. Lot No. \_\_\_\_\_, Recorded Plat \_\_\_\_\_  
5. Private Claims \_\_\_\_\_

	A	B	C	D	E	F	G	H	I	J	K	L	M
2	6	5	4	3	2	1							
3													
4	7	8	9	10	11	12							
5													
6	18	17	16	15	14	13							
7													
8	19	20	21	22	23	24							
9													
10	30	29	28	27	26	25							
11													
12	31	32	33	34	35	36							
13													

I, John C. Bueche, in a field survey on October 1, 1996, do hereby certify that under requirements of P.A. 74, Michigan P.A. of 1970, the corner points mentioned in lines 1 and 2 above were in conformance with regulations and rules therefore as required in the current manual of survey instructions of the United States Department of the Interior, Bureau of Land Management or by a decree of a Court of Law and/or that the corner points mentioned in lines 3, 4 and 5 above were in conformance with the rules of the Michigan Board of Land Surveyors or by a Decree of a Court of Law; established, re-established, monumented, re-monumented, recovered, found as expressed below:

**NOTE: Not more than 4 corners, all in the same town and range, may be recorded on this certificate.**

**A. Description of original monument and accessories and/or subsequent restoration:**

M-6 GLO	LCRC L1, P461, June 20,	Nederveld, 1992 Iron
Set HMP	1972, bolt spk. in iron	Fd. Nail SW side GP S 36° W 40.87'
Beech 10	C/L st. sign post SW 33.38'	C/L st. sign post S 40° W 43.72'
N 5 W 58	Nail in side fence post NW 40.57'	Fd. Nail SE side PP S 40° W 38.06'
Sugar 30	Nail in side fence post NNW 42.98'	Set PK N side PP S 83° W 151.64'
S 60 W 14	Nail in side fence post NNE 86.68'	Set PK S side PP N 70° W 154.45'
Lucius	E & W fence line S 53.5'	
Lyon		
Nov., 1831		

**B. Description of corner evidence found and/or method applied in restoring or reestablishing corner:**

M-6 Found 1/2" rebar & sq, spk. in 1 1/2" pipe down 18" in gravel road,  
As per above wit.  
C/L gravel rd. N-S, West 3'±  
On C/L gravel rd. W

And is accepted as a careful and faithful perpetuation of the position of the original corner.

P.A. 345 OTTAWA COUNTY  
PEER APPROVED 11-11-96


*J.C.B.*

**C. Description of monument for corner and accessories established to perpetuate locating the position of the corner:**

M-6 Replaced 1/2" rebar & 1 1/2" pipe with Ottawa Co. Mon. (3/4" x 24" pin with cap)  
Nail & Ottawa Co. Remon. Tag in S side PP N 80° W 154.38'  
Nail & Ottawa Co. Remon. Tag in N side PP S 85° W 151.56'  
Nail & Ottawa Co. Remon. Tag in SE side PP S 40° W 37.92'  
Nail & Ottawa Co. Remon. Tag in W side PP S 35° E 40.96'  
Nail & Ottawa Co. Remon. Tag in S side (4' up) in group of 6"-10" Box Elder N 40° E 37.74'  
On C/L gravel rd. W, C/L gravel rd. N-S is West 3'±

Signed by John C. Bueche  
Surveyor's Michigan License No. 13027

Date 11-7-96

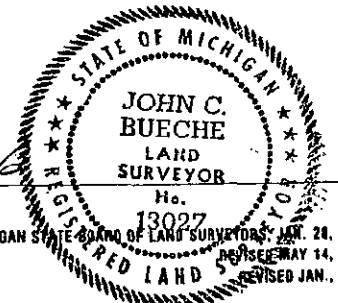

FORM APPROVED BY MICHIGAN STATE BOARD OF LAND SURVEYORS, JAN. 28, 1971  
REVISED MAY 14, 1975  
REVISED JAN., 1983

\$ 1.00 PHOTO