

SURVEY & REMONUMENTATION

APR 25 1995

COMMISSION

Ottawa County Remonumentation
LAND CORNER RECORDATION CERTIFICATE - 8 PM 12:38
 Filing Requirement of Act 74, Mich. P.A. 1970

RECORDED

Register of Deeds
 REGISTER OF DEEDS
 OTTAWA COUNTY, MI

For corners in

Ottawa
 (County)

Located In:

Corner Code #

- | | | | | | |
|------------------------------------|---|-----------|---|------------|----------------------------|
| 1. Public Land Survey | T | <u>5N</u> | R | <u>14W</u> | M-8 (E $\frac{1}{4}$, 24) |
| | T | | R | | <u>Zeeland Twp.</u> |
| | T | | R | | |
| | T | | R | | |
| 2. Property Controlling in Section | S | | T | R | |
| | S | | T | R | |
| 3. Miscellaneous Property in Sec. | S | | T | R | |
| | S | | T | R | |
4. Lot No. _____, Recorded Plat _____
5. Private Claims _____

Register of Deeds Stamp & File Number

	A	B	C	D	E	F	G	H	I	J	K	L	M
2	6	5	4	3	2	1							
3													
4	7	8	9	10	11	12							
5													
6	18	17	16	15	14	13							
7													
8	19	20	21	22	23	24							
9													
10	30	29	28	27	26	25							
11													
12	31	32	33	34	35	36							
13													

John C. Bueche, in a field survey on October 10, 19 94, do hereby certify that under requirements of P.A. 74, Michigan P.A. of 1970, the corner points mentioned in lines 1 and 2 above were in conformance with regulations and rules therefore as required in the current manual of survey instructions of the United States Department of the Interior, Bureau of Land Management or by a decree of a Court of Law and/or that the corner points mentioned in lines 3, 4 and 5 above were in conformance with the rules of the Michigan Board of Land Surveyors or by a Decree of a Court of Law; established, re-established, monumented, re-monumented, recovered, found as expressed below:

NOTE: Not more than 4 corners, all in the same town and range, may be recorded on this certificate.

A. Description of original monument and accessories and/or subsequent restoration:

M-8 GLO Nov., 1831	LCRC L5-P347, Dec., 1988
Sylvester Sibley, D.S.	CIM
Set post	CIM W 1/4 cor. 19, 5-13 S 41.25'
Sugar 10 N 20 W 38	PP WNW 45.59'
Elm 13 S 50 W 23	1/2" rod SW 74.93'
	"T" cut in conc. culv. SE 22.65'
	1/2" rod NE 35.00'


3. Description of corner evidence found and/or method applied in restoring or reestablishing corner:

M-8 Found Ottawa Co. Mon. (Harrison Mon.)
 As per above wit.

And is accepted as a careful and faithful perpetuation of the position of the original corner.

P.A. 345 OTTAWA COUNTY
 PEER APPROVED 11/21/94

Handwritten signature

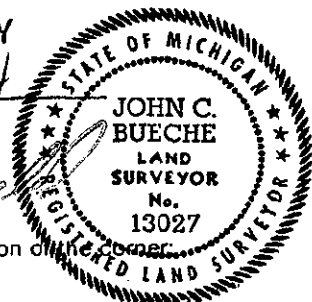

C. Description of monument for corner and accessories established to perpetuate locating the position of the corner:

M-8 Ottawa Co. Mon. (Harrison Mon.)	
Nail & 2" Tag in S side PP	N 70 W 45.48'
"X" cut in top of conc. culv. W end	S 60 W 24.07'
"X" cut in top of conc. culv. E end	S 50 E 22.65'
Ottawa Co. Mon. (Harrison Mon.) W 1/4 cor. Sec. 19, 5-13	S 41.25'
On field division W	
C/L ditch E-W,	S 15'±
On C/L gravel rd. N-S	

Signed by John C. Bueche
 John C. Bueche
 Surveyor's Michigan License No. 13027

Date 11-18-94