

SURVEY & REMONUMENTATION

APR 25 1995

COMMISSION

Ottawa County Remonumentation
LAND CORNER RECORDATION CERTIFICATE
Filing Requirement of Act 74, Mich. P.A. 1970

RECORDED

94 DEC -8 PM 12:38

D. J. ...
REGISTER OF DEEDS
OTTAWA COUNTY, MI

For corners in
Ottawa

(County)

Located In:

Corner Code #

- | | | |
|---------------------------------------|--------------------------|-----------------------------|
| i. Public Land Survey | T <u>5N</u> R <u>14W</u> | M-10 (E $\frac{1}{2}$, 25) |
| | T _____ R _____ | <u>Zeeland Twp.</u> |
| | T _____ R _____ | _____ |
| | T _____ R _____ | _____ |
| 2. Property Controlling in Section | S _____ T _____ R _____ | _____ |
| | S _____ T _____ R _____ | _____ |
| 3. Miscellaneous Property in Sec. | S _____ T _____ R _____ | _____ |
| | S _____ T _____ R _____ | _____ |
| 4. Lot No. _____, Recorded Plat _____ | | |
| 5. Private Claims _____ | | |

Register of Deeds Stamp & File Number

I, John C. Bueche, in a field survey on October 10, 19 94, do hereby certify that under requirements of P.A. 74, Michigan P.A. of 1970, the corner points mentioned in lines 1 and 2 above were in conformance with regulations and rules therefore as required in the current manual of survey instructions of the United States Department of the Interior, Bureau of Land Management or by a decree of a Court of Law and/or that the corner points mentioned in lines 3, 4 and 5 above were in conformance with the rules of the Michigan Board of Land Surveyors or by a Decree of a Court of Law; established, re-established, monumented, re-monumented, recovered, found as expressed below:

A	B	C	D	E	F	G	H	I	J	K	L	M
2	6	5	4	3	2	1						
3												
4	7	8	9	10	11	12						
5												
6	18	17	16	15	14	13						
7												
8	19	20	21	22	23	24						
9												
10	30	29	28	27	26	25						
11												
12	31	32	33	34	35	36						
13												

NOTE: Not more than 4 corners, all in the same town and range, may be recorded on this certificate.

A. Description of original monument and accessories and/or subsequent restoration:

M-10 GLO Nov., 1831	LCRC L1-P185
Sylvester Sibley, D.S.	T iron
Set post	16" Oak S 42 E 38.19'
Beech 20 N 28 W 18	16" Oak S 15 E 68.40'
Beech 14 S 10 W 40	CP pole S 10 W 100.94'
	C/L gravel rd E 6'±


B. Description of corner evidence found and/or method applied in restoring or reestablishing corner:

M-10 Found T iron	16" Oak S 42 E 38.19'
	16" Oak S 15 E 68.40'

And is accepted as a careful and faithful perpetuation of the position of the original corner.

P.A. 345 OTTAWA COUNTY
PEER APPROVED 11/21/94

Handwritten signature

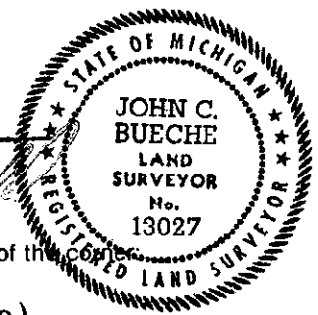

C. Description of monument for corner and accessories established to perpetuate locating the position of the corner:

M-10 Replace T iron with Ottawa Co. (3/4" x 24" Pin with Cap)	
Nail & Ottawa Co. Remon. Tag in N side 16" Oak	S 40 E 38.46'
Nail & Ottawa Co. Remon. Tag in N side 24" Oak	S 15 E 69.17'
Nail & Ottawa Co. Remon. Tag in W side PP	S 10 W 102.46'
Nail & Ottawa Co. Remon. Tag in S side 6" Box Elder	N 80 W 39.03'
Nail & Ottawa Co. Remon. Tag in W side PP	N 05 W 103.84'
T iron W 1/4 cor. Sec. 30, 5-13	S 13.12'
C/L gravel rd. N-S	E 6'±
On field division W	

Signed by John C. Bueche
John C. Bueche
Surveyor's Michigan License No. 13027

Date 11-18-94