

**SURVEY &
REMONUMENTATION**

FEB 27 1998

**Ottawa Co. Remonumentation
LAND CORNER RECORDATION CERTIFICATE
Filing Requirement of Act 74, Mich. P.A. 1970**

SECTION

For corners in

<u>Ottawa</u> (County)	Located In:	Corner Code #
1. Public Land Survey	T <u>5N</u> R <u>14W</u>	<u>M-4</u>
	T _____ R _____	<u>Zeeland Twp.</u>
	T _____ R _____	_____
	T _____ R _____	_____
2. Property Controlling in Section	S _____ T _____ R _____	<u>Seg. #2 pm</u>
	S _____ T _____ R _____	_____
3. Miscellaneous Property in Sec.	S _____ T _____ R _____	_____
	S _____ T _____ R _____	_____

RECORDED

97 DEC -8 AM 11:30

Sam S. Baller
REGISTER OF DEEDS
OTTAWA COUNTY, MI

Register of Deeds Stamp & File Number

4. Lot No. _____, Recorded Plat _____
5. Private Claims _____

I, Rodney D. Unema, in a field survey on Nov. 26, 19 97, do hereby certify that under requirements of P.A. 74, Michigan P.A. of 1970, the corner points mentioned in lines 1 and 2 above were in conformance with regulations and rules therefore as required in the current manual of survey instructions of the United States Department of the Interior, Bureau of Land Management or by a decree of a Court of Law and/or that the corner points mentioned in lines 3, 4 and 5 above were in conformance with the rules of the Michigan Board of Land Surveyors or by a Decree of a Court of Law; established, re-established, monumented, re-monumented, recovered, found as expressed below:

NOTE: Not more than 4 corners, all in the same town and range, may be recorded on this certificate.

A. Description of original monument and accessories and/or subsequent restoration:

M-4 Remon Liber 2, Page 230 (Dec. 15, 1994)

Ottawa Co. Mon. (4" Harrison with top broke off)

- Nail & Ottawa County Remon. Tag in S side 8" Apple S80°E 73.83'
- Nail & Ottawa County Remon. Tag in N side 18" Oak N65°E 65.82'
- Nail & Ottawa County Remon. Tag in W side PP S25°W 75.03'
- Top & conc. ROW marker N35°E 60.05'

Field division W, N 12'+
& gravel N-S, E 2'+; & gravel E, S 46'+

Jamestown cor. iron S 45.81'

B. Description of corner evidence found and/or method applied in restoring or reestablishing corner:

M-4

Found Ottawa Co. Mon. as described in Remon. Liber 2, Page 230

Found Nail & O.C. Tag in S side 8" Apple S80°E 73.86'

Found Nail & O.C. Tag in NW side 18" Oak N65°E 65.85'

Top & conc. R.O.W. marker N35°E 60.26'

-Rewitnessed corner and after road construction held witnesses to set standard Ottawa County Cap on 24" X 3/4" Steel Bar in Mon. Box

P.A. 345 OTTAWA COUNTY

PEER APPROVED 12-1-97
RDU

C. Description of monument for corner and accessories established to perpetuate locating the position of the corner:

M-4 E 1/4 Corner of Section 12

Standard Ottawa County Cap on 24" X 3/4" Steel Bar in Mon. Box

Nail & O.C. Tag in S side 8" Apple S80°E 73.86'

Nail & O.C. Tag in NW side 18" Oak N65°E 65.85'

Top & conc. R.O.W. marker N35°E 60.26'


Nail & O.C. Tag in E end 24" CMP N30°E 83.70'

Nail & O.C. Tag in W end 24" CMP N15°W 76.65'

O.C. Mon. A-4, Jamestown Twp. South 45.81'

& N-S B.T. Road East 2'

& Gravel Road to East South + 46'

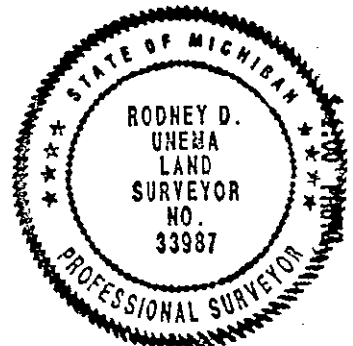

Signed by Rodney D. Unema
Surveyor's Michigan License No. 33987

Date Dec. 1, 1997