

SURVEY & REMONUMENTATION

DEC 01 1998

SECTION

Ottawa County Remonumentation
LAND CORNER RECORDATION CERTIFICATE
 Filing Requirement of Act 74, Mich. P.A. 1970

RECORDED
 98 MAY 22 PM 4: 06

For corners in

<u>Ottawa</u> (County)	Located In:	Corner Code #
1. Public Land Survey	T <u>5N</u> R <u>15W</u>	<u>A-3 (NW, 7)</u>
	T _____ R _____	<u>Holland Twp.</u>
	T _____ R _____	_____
	T _____ R _____	_____
2. Property Controlling in Section	S _____ T _____ R _____	_____
	S _____ T _____ R _____	_____
3. Miscellaneous Property in Sec.	S _____ T _____ R _____	_____
	S _____ T _____ R _____	_____
4. Lot No. _____, Recorded Plat _____		
5. Private Claims _____		

Sam Schellton
 REGISTER OF DEEDS
 OTTAWA COUNTY, MI

Register of Deeds Stamp & File Number

I, John C. Bueche, in a field survey on March 30, 1998, do hereby certify that under requirements of P.A. 74, Michigan P.A. of 1970, the corner points mentioned in lines 1 and 2 above were in conformance with regulations and rules therefore as required in the current manual of survey instructions of the United States Department of the Interior, Bureau of Land Management or by a decree of a Court of Law and/or that the corner points mentioned in lines 3, 4 and 5 above were in conformance with the rules of the Michigan Board of Land Surveyors or by a Decree of a Court of Law; established, re-established, monumented, re-monumented, recovered, found as expressed below:

A	B	C	D	E	F	G	H	I	J	K	L	M
2	6	5	4	3	2							
3												
4	7	8	9	10	11	12						
5												
6	18	17	16	15	14	13						
7												
8	19	20	21	22	23	24						
9												
10	30	29	28	27	26	25						
11												
12	31	32	33	34	35	36						
13												

NOTE: Not more than 4 corners, all in the same town and range, may be recorded on this certificate.

A. Description of original monument and accessories and/or subsequent restoration:

A-3 GLO	LCRC July, 1972	LCRC 5-16 March, 1983
Calvin Britain, 1832	Fnd. steel rod	Steel rod
West boundary 38 North of post & set cor.	SE cor. attached garg.	NE 61.90' Nail & Cap N. side
Secs. 6 & 7	NW 93.17'	24" Maple
Alder 4 N 40 E 58	NE cor. attached garg.	S 25.71' to Park Twp. cor.
Aspen 10 S 60 E 1.32	NW 105.41'	SW 73.87' Nail & Cap E side PP
	Park cor. South 25.70'	WNW 93.07' SE cor. brick garg.
		WNW 25.37' PK SW side PP
		NW 105.41' NE cor. brick garg.

B. Description of corner evidence found and/or method applied in restoring or reestablishing corner: OVER

A-3 Found PK & washer 0.11' West of Township Line
 Between M-3 (SE 1) & M-2 (E-1) 5-16

As per above wit.


And is accepted as a careful and faithful perpetuation of the position of the original corner.

PEER APPROVED 4/20/98

[Signature]

C. Description of monument for corner and accessories established to perpetuate locating the position of the corner:

A-3 Set 3/4" x 24" pin & cap & Mon. Box on Township Line (removed PK)
 Ottawa Co. Remon. Tag & Nail in N side 32" Maple N 78° E 61.36'
 Ottawa Co. Remon. Tag & Nail in SE side PP S 20° W 73.98'
 Ottawa Co. Remon. Tag & Nail in NE side 14" Quad. Maple N 80° W 58.28'
 SE cor. brick garg. to hse. N 60° W 93.01'
 Top C/L hydt. N 77° E 42.27'
 Ottawa Co. Mon. in Mon. Box M-3 (SE 1, 5-16) S 25.69'
 PK E. 1.98' & S. 1.97'
 On C/L bit. road N-S; C/L bit. E-W South 26'±

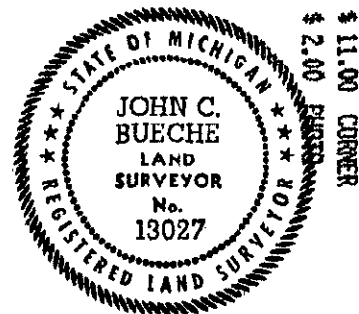

Signed by John C. Bueche Date 4-1-98
 John C. Bueche, P.S. 13027
 Surveyor's Michigan License No. _____

FORM APPROVED BY MICHIGAN STATE BOARD OF LAND SURVEYORS, JAN. 28, 1971
 REVISED MAY 14, 1976
 REVISED JAN., 1983

SURVEY &
REMONUMENTATION

DEC 01 1998

A-3
PART A - continued

SECTION

Exxel Survey Dec., 1992
Cast Mon.
ENE 61.45' Nail S side 30" Maple
SE 68.65' "X" cut NE end 18" culvt.
SW 73.85' Nail & Tag E side PP
NW 93.02' SE cor. brick garg.

