

**SURVEY &
REMONUMENTATION**

DEC 01 1998

Ottawa County Remonumentation
LAND CORNER RECORDATION CERTIFICATE
Filing Requirement of Act 74, Mich. P.A. 1970

RECORDED

98 MAY 22 PM 4: 06

For corners in **SECTION**

<u>Ottawa</u> (County)	Located In:	Corner Code #
1. Public Land Survey	T <u>5N</u> R <u>15W</u>	A-6 (W $\frac{1}{2}$, 18) Holland Twp.
	T _____ R _____	_____
	T _____ R _____	_____
	T _____ R _____	_____
2. Property Controlling in Section	S _____ T _____ R _____	_____
	S _____ T _____ R _____	_____
3. Miscellaneous Property in Sec.	S _____ T _____ R _____	_____
	S _____ T _____ R _____	_____

Handwritten Signature
REGISTER OF DEEDS
OTTAWA COUNTY, MI

Register of Deeds Stamp & File Number

4. Lot No. _____, Recorded Plat _____
5. Private Claims _____

	A	B	C	D	E	F	G	H	I	J	K	L	M
2	6		5		4		3		2				
3													
4	7		8		9		10		11		12		
5													
6	18		17		16		15		14		13		
7													
8	19		20		21		22		23		24		
9													
10	30		29		28		27		26		25		
11													
12	31		32		33		34		35		36		
13													

I, John C. Bueche, in a field survey on April 3, 19 98, do hereby certify that under requirements of P.A. 74, Michigan P.A. of 1970, the corner points mentioned in lines 1 and 2 above were in conformance with regulations and rules therefore as required in the current manual of survey instructions of the United States Department of the Interior, Bureau of Land Management or by a decree of a Court of Law and/or that the corner points mentioned in lines 3, 4 and 5 above were in conformance with the rules of the Michigan Board of Land Surveyors or by a Decree of a Court of Law, established, re-established, monumented, re-monumented, recovered, found as expressed below:

NOTE: Not more than 4 corners, all in the same town and range, may be recorded on this certificate.

A. Description of original monument and accessories and/or subsequent restoration:

A-6 GLO Did not set corner	LCRC 3-341, Feb., 1979 Set steel bar Does not say how Park Twp. cor. S 18.19' 8" Pine NW 56.55' 10" Oak SW 69.80'	LCRC 5-160, Oct., 1984 Set cast iron mon. (from closing cor. & Oak) S 18.18' Park Twp. cor. NE 29.92' Nail SE side PP W 63.65' PK side 4" Poplar SW 69.74' PK N side 15" Oak ESE 59.79' Nail S side Twin 12" Oak
-------------------------------	--	--

B. Description of corner evidence found and/or method applied in restoring or reestablishing corner:

A-6 Found 4" Harrison Mon. in Mon. Box; 0.12' W of Township Line between
M-6 (E 1/4 13) & M-5 (NE 13), 5-16; C/L bit. N-S East 2'±
Park Twp. cor. S 18.19' ESE 59.79' Twin 12" Oak
17" Beech SE 107.89'


This position not established by original government surveyors.
This monument is accepted as the best available evidence of the position of the corner.

OTAWA COUNTY

Handwritten Signature 4/20/98

C. Description of monument for corner and accessories established to perpetuate locating the position of the corner:

A-6 Wit. to point on Mon. 0.12' East C/L of existing Mon. in Mon. Box
Nail & Ottawa Co. Remon. Tag in N side PP N 71° E 29.90'
Nail & Ottawa Co. Remon. Tag in SW side 20" Beech S 30° E 108.04'
Nail & Ottawa Co. Remon. Tag in SW side 10" Pine N 55° W 66.60'
NE cor. siding to garg. S 30° E 131.83'
NW cor. conc. porch S 55° E 86.92'
Ottawa Co. Mon. in Mon. Box M-6 (E 1/4 13, 5-16) South 18.18'
C/L bit. N-S is East 2'±; C/L bit. E-W South 18'±

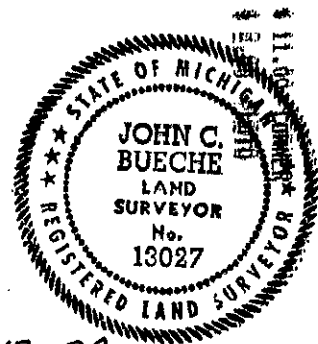

Signed by John C. Bueche Date 4-13-98
Surveyor's Michigan License No. 13027

SURVEY &
REMONUMENTATION

DEC 01 1998

A-6
PART A - continued

LCRC can not read, June, 1984

CIM

Park Twp. cor. S. 18.16'

PP NE 38.87'

17" Beech SE 107.89'

13" Oak SW 70.22'

SECTION

