SURVEY & REMONUMENTATION

DEC 01 1998

SECTION

RECORDED

98 MAY 22 PM 4:06

REGISTER OF DEEDS
OTTAWA COUNTY, MI

Ottawa County Remonumentation

LAND CORNER RECORDATION CERTIFICATE

Filing Requirement of Act 74, Mich. P.A. 1970

For corners in

Ottawa (County)

	Located In:	Corner Code ##
1. Public Land Survey	T 5N R 15W	A-8 (W½, 19)
	T ___ R ___	Holland Twp.
	T ___ R ___	
	T ___ R ___	
2. Property Controlling	S ___ T ___ R ___	
in Section	S ___ T ___ R ___	
3. Miscellaneous	S ___ T ___ R ___	
Property in Sec.	S ___ T ___ R ___	

Register of Deeds Stamp & File Number

4. Lot No. _____ , Recorded Plat _____
5. Private Claims _____

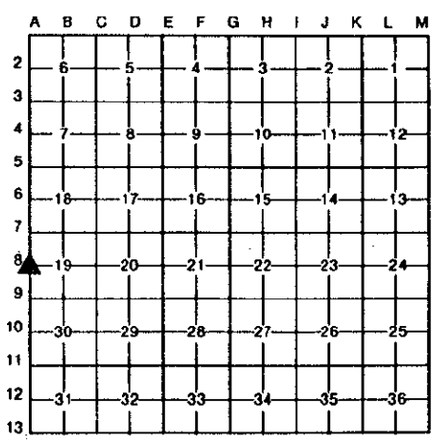

I, John C. Bueche, in a field survey on April 3, 19 98, do hereby certify that under requirements of P.A. 74, Michigan P.A. of 1970, the corner points mentioned in lines 1 and 2 above were in conformance with regulations and rules therefore as required in the current manual of survey instructions of the United States Department of the Interior, Bureau of Land Management or by a decree of a Court of Law and/or that the corner points mentioned in lines 3, 4 and 5 above were in conformance with the rules of the Michigan Board of Land Surveyors or by a Decree of a Court of Law; established, re-established, monumented, re-monumented, recovered, found as expressed below:

NOTE: Not more than 4 corners, all in the same town and range, may be recorded on this certificate.

A. Description of original monument and accessories and/or subsequent restoration:

A-8 GLO
Did not set corner

LCRC 1-175, Dec., 1971
Fnd. pinched pipe
Nail in face PP NW 25.90'
Nail in face PP NE 53.20'
Nail in face PP NE 79.12'
Nail in face 14" Maple SW 70.40'
NW cor. hse. SE 158.56'
Iron pipe Park Twp. South 13.90'

LCRC 6-183, Nov., 1991
Fnd. 1" pipe in mon. box
Set CIM
Park cor. 13.91' (no direction)
PP NE 53.61'
PP NW 29.27'
18" Oak SE 94.45'
OVER

B. Description of corner evidence found and/or method applied in restoring or reestablishing corner:

A-8 Found broken Harrison Mon. in Mon. Box & capped iron (can not read) East 1.45'
Capped iron is on Township Line between M-8 (E 1/4 24) & M-7 (NE 24), 5-16

PP NE 79.12'±
NW cor. hse. SE 158.56'
Park cor. S 13.90'

18" Oak SE 94.45'±
24" Oak NNE 71.86'±
14" Oak SE 94.36'±

This position not established by original government surveyors.
This monument is accepted as the best available evidence of the position of the corner.

P.A. 345 OTTAWA COUNTY
PLAT APPROVED 4/20/98

C. Description of monument for corner and accessories established to perpetuate locating the position of the corner:

A-8 Replaced capped rerod with 3/4" x 24" Pin with Ottawa Co. Cap in Mon. Box
Ottawa Co. Remon. Tag & Nail in NW side 32" Oak N 30° E 71.65'
New Ottawa Co. Remon. Tag & Nail in NE side PP N 50° W 31.46'
Ottawa Co. Remon. Tag & Nail in E side PP S 10° W 135.53'
Ottawa Co. Remon. Tag & Nail in NE side 20" Oak S 40° E 93.62'
Ottawa Co. Mon. (E 1/4 24, 5-16) South 13.94'; broken Mon. in Mon. Box West 1.45'
C/L bit. road E-W South 14'±
C/L bit. road N-S is East 1'±
Mon. in Mon. Box West 1.45'

STATE OF MICHIGAN
JOHN C. BUECHE
LAND SURVEYOR
No. 13027
REGISTERED LAND SURVEYOR

$ 11.00 CORNER
$ 2.00 FEE

Signed by John C Bueche Date 4-13-98
John C. Bueche, P.S.
Surveyor's Michigan License No. 13027

FORM APPROVED BY MICHIGAN STATE BOARD OF LAND SURVEYORS, JAN. 28, 1971
REVISED MAY 14, 1975
REVISED JAN., 1983

SURVEY &
REMONUMENTATION

DEC 01 1998

SECTION

A-8
PART A - continued

HEI (notes)
HEI, 1979
Fnd. 1" x 8" iron, replaced with 3/4"
PK S side PP NE 79.41'
PK NE side PP NW 29.26'
Nail & Washer SE side PP NNE 53.69'
Nail & Washer NW side PP SSW 45.11'
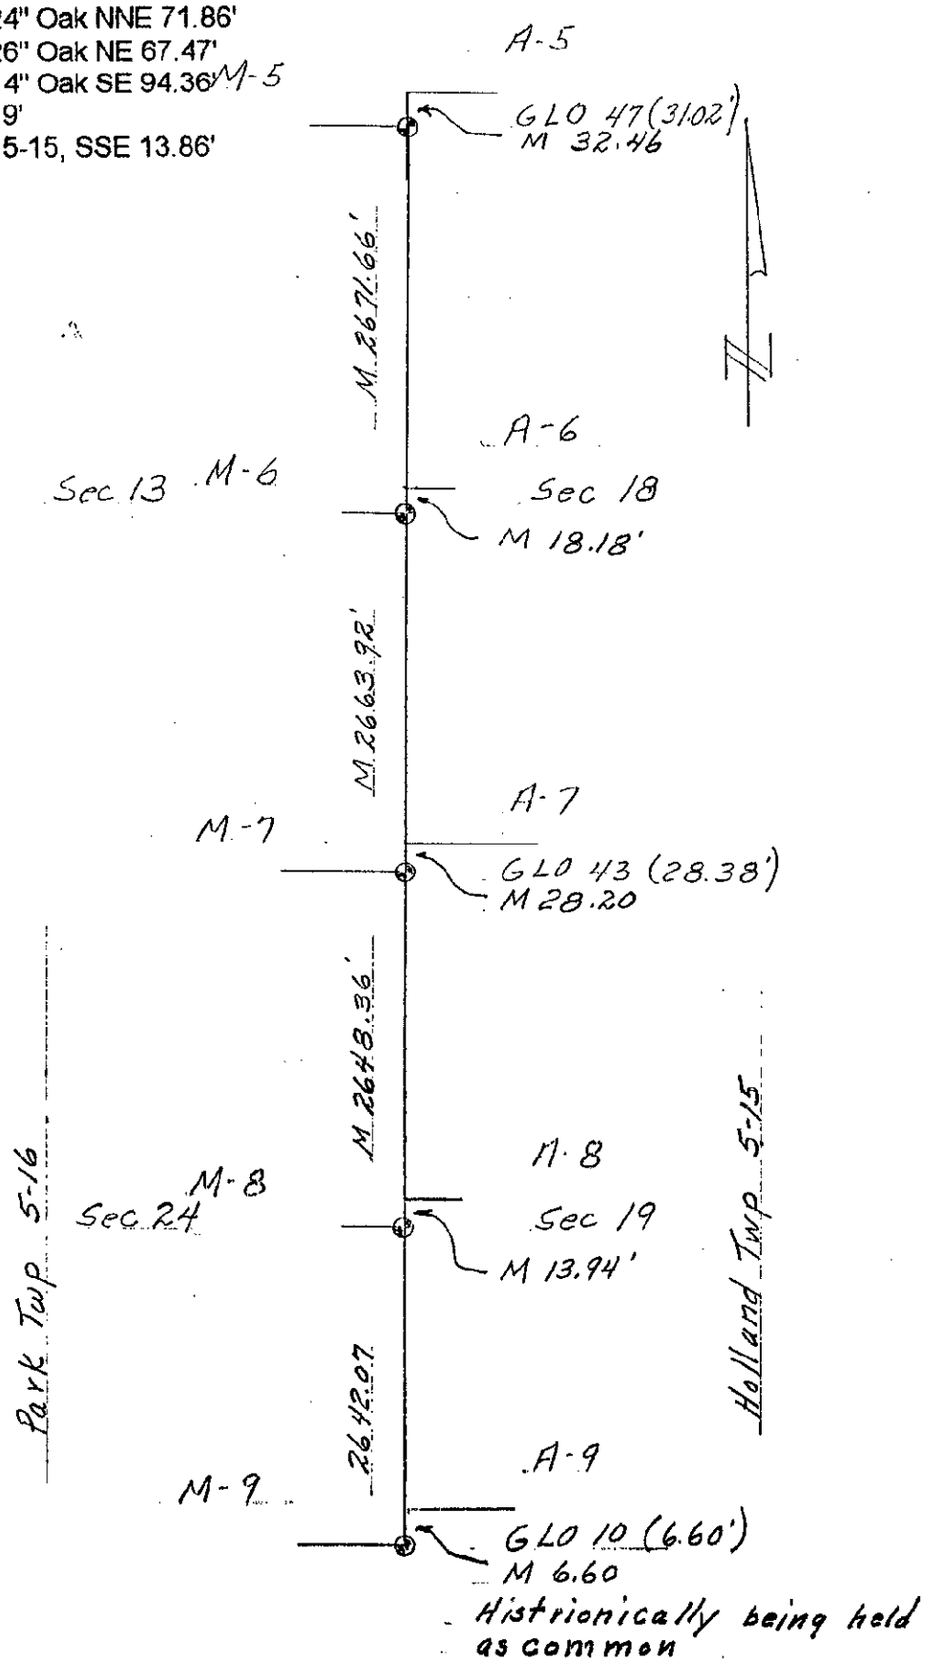
HEI, 1983
#14091 SE side 24" Oak NNE 71.86'
#14091 SE side 26" Oak NE 67.47'
#14091 SE side 14" Oak SE 94.36'
C/L hydt. NE 63.19'
E ¼ cor. Sec. 24, 5-15, SSE 13.86'