

FEB 24 2000

OTTAWA COUNTY REMONUMENTATION  
LAND CORNER RECORDATION CERTIFICATE  
Filing Requirement of Act 74, Mich. P.A. 1970

RECORDED

99 OCT 27 PM 1:50

SECTION

For corners in

Ottawa  
(County)

Located In:

Corner Code #

*Ray Sibley*  
REGISTER OF DEEDS  
OTTAWA COUNTY, MI

- 1. Public Land Survey T5N R15W A-13  
T R  
T R Southwest corner  
T R Section 31
- 2. Property Controlling S T R  
in Section S T R  
3. Miscellaneous S T R  
Property in Sec. S T R

Register of Deeds Stamp & File Number

- 4. Lot No. \_\_\_\_\_, Recorded Plat \_\_\_\_\_
- 5. Private Claims \_\_\_\_\_

I, Steve Lampen \_\_\_\_\_, in a field survey on September 14, 1999, do hereby certify that under requirements of P.A. 74, Michigan P.A. of 1970, the corner points mentioned in lines 1 and 2 above were in conformance with regulations and rules therefore as required in the current manual of survey instructions of the United States Department of the Interior, Bureau of Land Management or by a decree of a Court of Law and/or that the corner points mentioned in lines 3, 4 and 5 above were in conformance with the rules of the Michigan Board of Land Surveyors or by a Decree of a Court of Law; established, re-established, monumented, re-monumented, recovered, found as expressed below:

1	A	B	C	D	E	F	G	H	I	J	K	L	M
2	6	5	4	3	2	1							
3													
4	7	8	9	10	11	12							
5													
6	18	17	16	15	14	13							
7													
8	19	20	21	22	23	24							
9													
10	30	29	28	27	26	25							
11													
12	31	32	33	34	35	36							
13													

NOTE: Not more than 4 corners, all in the same town and range, may be recorded on this certificate.

A. Description of original monument and accessories and/or subsequent restoration:

A-13 = M-13, T5N, R16W LCRC, L2, P117 - Englert - 1973  
 GLO - Sibley - 1832 Survey by Peck, November 1892 1" iron in monument box  
 Set post corner L-13 to M-13 = 2640 SE 40.06 power pole  
 Town's 4 & 5 of Range's 15 & 16 W M-12 to M-13 = 2653.5 SW 32.60 street sign  
 Beech 6 N 59 E 53 NW 37.00 guy pole  
 Hemlock 8 S 31 W 25 NE 44.27 telephone pole

A-13 is shown on Survey L3, P178 - 1976  
 1" pipe in monument box  
 Power pole SE 40.06  
 Telephone pole NE 44.27

M-13 is SE corner of Heneveld's  
 Supervisor's Plat No. 14 (1934)  
 L-13 to M-13 is Plat = 2630.5

*9/20/99  
YDP*

B. Description of corner evidence found and/or method applied in restoring or reestablishing corner:

A-13 Found 1" pipe in monument box.  
 M-13 to L-13 rec. = 2640 (Peck) + 2630.5 (Plat) meas. 2629.88

M-13 to M-12 rec. 2653.5 (peck) + 2647.1 (Heneveld's No.'s 13 & 14) meas. 2642.89  
 North line of SW 1/4, SW 1/4, Section 31 as monumented by Sandy's Subdivision (1953) is 1321.44' North of found pipe.

North line SE 1/4, SE 1/4, Section 36, as monumented by Sherwood Forest (1957) and Larkwood Plat (1959) is 1321.44' North of found pipe. See sketch on back.

A-13, T5N, R15W = M-13, T5N, R16W = A-1, T4N, R15W = M-1, T4N, R16W


Found position of the corner fits the monumentation of many recent plats and surveys in both Ottawa and Allegan Counties.

Replaced pipe with an Ottawa County Remonumentation iron and cap and is accepted as the best position of the corner.

C. Description of monument for corner and accessories established to perpetuate locating the position of the corner:

A-13 Ottawa County Remonumentation iron and cap in monument box  
 Azimuth = Michigan State Plane grid direction

Remonumentation tag in South side 16" Maple	224° 51'	98.80
Remonumentation tag in North side 12" Pine	112° 18'	102.98
Remonumentation tag in Northwest side 18 Pine	48° 50'	137.79
Southwest corner garage foundation	334° 31'	209.70

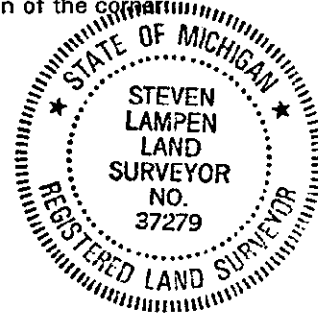

Receipt #61757

Signed by *Steven Lampen*

Date OCTOBER 16, 1999

Surveyor's Michigan License No. 37279

FORM APPROVED BY MICHIGAN STATE BOARD OF LAND SURVEYORS, JAN. 28, 1971  
 REVISED MAY 14, 1975  
 REVISED JAN., 1983  
 ADAPTED FOR WORD PROCESSING MARCH, 1993

FEB 24 2000

SECTION



M-12 A-12

M 662.8  
P 663.4

(1934)  
S. LINE HENEVELD'S No. 13

± 26<sup>TH</sup> ST.

N. LINE HENEVELD'S No. 14  
(1934)

1321.44

A-13 TO A-12  
PECK = 2653.5  
HEN. NO. 13 + 14 = 2647.1  
MEAS. = 2642.89

(1957)

S. LINE SHERWOOD FOREST

N. LINE LARKWOOD PLAT  
(1959)

N. LINE SANDY'S SUB (1953)

M 1980.09  
P 1983.7

1321.44

± GRAEFSHAP ROAD

M-13 A-13

M-1 A-1