

FEB 24 2000

OTTAWA COUNTY REMONUMENTATION  
LAND CORNER RECORDATION CERTIFICATE  
Filing Requirement of Act 74, Mich. P.A. 1970

RECORDED  
99 OCT 27 PM 1:49

SECTION

For corners in

Ottawa  
(County)

Located In:

Corner Code #

- 1. Public Land Survey T5N R15W B-7  
T R  
T R  
T R  
T R
- 2. Property Controlling S T R  
in Section S T R
- 3. Miscellaneous S T R  
Property in Sec. S T R

North 1/4 corner  
Section 19,  
Holland Twp.

*Ray Schiller*  
REGISTER OF DEEDS  
OTTAWA COUNTY, MI

Register of Deeds Stamp & File Number

- 4. Lot No. \_\_\_\_\_, Recorded Plat \_\_\_\_\_
- 5. Private Claims \_\_\_\_\_

	A	B	C	D	E	F	G	H	I	J	K	L	M
1													
2	6		5		4		3		2		1		
3													
4	7		8		9		10		11		12		
5													
6	18		17		16		15		14		13		
7	19		20		21		22		23		24		
8													
9													
10	30		29		28		27		26		25		
11													
12	31		32		33		34		35		36		
13													

I, Steve Lampen, in a field survey on September 14, 1999, do hereby certify that under requirements of P.A. 74, Michigan P.A. of 1970, the corner points mentioned in lines 1 and 2 above were in conformance with regulations and rules therefore as required in the current manual of survey instructions of the United States Department of the Interior, Bureau of Land Management or by a decree of a Court of Law and/or that the corner points mentioned in lines 3, 4 and 5 above were in conformance with the rules of the Michigan Board of Land Surveyors or by a Decree of a Court of Law; established, re-established, monumented, re-monumented, recovered, found as expressed below:

NOTE: Not more than 4 corners, all in the same town and range, may be recorded on this certificate.

A. Description of original monument and accessories and/or subsequent restoration:

- B-7 Peck - 1900 LCRC, L1, P175 - Greer - 1971  
GLO - Brookfield - 1832 Gas pipe and stake Found iron pipe  
Set 1/2 mile post B-7 to A-7 = 2775 24" Maple NW 51.23  
Hemlock 12 S 8 B-7 to C-7 = 2640 Power pole SE 84.72  
Hemlock N 8 E 24 B-7 to B-8 = 2646 Power pole SW 73.84  
Power pole NW 121.72  
SW corner house NE 138.10

B-7 is shown on Plat of Howard's Second Addition - 1910

- LCRC, L1, P455 - Bonnema - 1972  
3/4" Iron stake  
Nail in side 28" Maple NNW 52.46  
Nail in side 6" Pine SW 58.09  
Nail in side T+P pole ESE 85.17  
Nail in side 7" Pine ENE 105.50

B. Description of corner evidence found and/or method applied in restoring or reestablishing corner:

B-7 Found 1/2" iron in monument box, 24" Cherry NW 51.23 (no nail), power pole SW 73.84, power pole NW 121.72

B-7 to A-7 Peck = 2795 meas. = 2795.59 B-7 to C-7 Peck = 2640 meas. = 2639.33 B-7 to B-8 Peck = 2646 meas. = 2646.51


Found 1/2" iron fits the monumentation of Howard's Second Addition and many other plats and surveys.

Replaced 1/2" iron with an Ottawa County Remonumentation iron and cap and accepted it as a careful and faithful perpetuation of the position of the original corner.

9/20/99  
*GD*

C. Description of monument for corner and accessories established to perpetuate locating the position of the corner:

- B-7 Ottawa County Remonumentation iron and cap in monument box in monument box.
- Azimuth - Michigan State Plane grid direction
- Remonumentation tag in S side power pole 249° 42' 70.06
- Remonumentation tag in S side power pole 108° 06' 87.36
- Remonumentation tag in SW side 26" Cherry 330° 08' 52.46
- Hydrant, top centerline 47° 02' 48.41

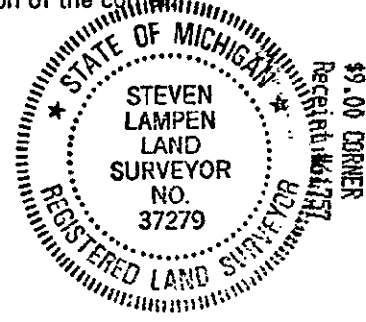

Signed by *Steven Lampen*

Date OCTOBER 16, 1999

Surveyor's Michigan License No. 37279