

FEB 24 2000

OTTAWA COUNTY REMONUMENTATION
LAND CORNER RECORDATION CERTIFICATE
Filing Requirement of Act 74, Mich. P.A. 1970

RECORDED
99 OCT 27 PM 1:50

Sam S. [Signature]
REGISTER OF DEEDS
OTTAWA COUNTY, MI

For corners in SECTION
Ottawa (County)

Located In: Corner Code #
T5N R15W B-9
T R
T R North 1/4 corner
T R Section 30
S T R Holland Township
S T R
S T R
S T R

Register of Deeds Stamp & File Number

- 1. Public Land Survey
- 2. Property Controlling in Section
- 3. Miscellaneous Property in Sec.
- 4. Lot No. _____, Recorded Plat _____
- 5. Private Claims _____

1	A	B	C	D	E	F	G	H	I	J	K	L	M
2	6	5	4	3	2	1							
3													
4	7	8	9	10	11	12							
5													
6	18	17	16	15	14	13							
7													
8	19	20	21	22	23	24							
9	30	29	28	27	26	25							
10													
11													
12	31	32	33	34	35	36							
13													

I, Steve Lampen, in a field survey on September 14, 1999, do hereby certify that under requirements of P.A. 74, Michigan P.A. of 1970, the corner points mentioned in lines 1 and 2 above were in conformance with regulations and rules therefore as required in the current manual of survey instructions of the United States Department of the Interior, Bureau of Land Management or by a decree of a Court of Law and/or that the corner points mentioned in lines 3, 4 and 5 above were in conformance with the rules of the Michigan Board of Land Surveyors or by a Decree of a Court of Law; established, re-established, monumented, re-monumented, recovered, found as expressed below:

NOTE: Not more than 4 corners, all in the same town and range, may be recorded on this certificate.

A. Description of original monument and accessories and/or subsequent restoration:
B-9 Peck - 1890's
GLO - Brookfield - 1832 Iron stake
Set 1/2 mile post 73' S of centerline railroad
W Ash 18 S 48 W 26 B-9 to A-9 = 2798
W Ash 20 N 25 E 43 B-9 to centerline Howard = 452.8
A-9 is shown on Plats 2
Plat of NW 1/4 - 1848
Howard's Addition - 1872
Hyma's Supervisor's Resubdivision - 1935

LCRC, L1, P807 - Clapp - 1972
Found steel bar in monument box
Power pole SW 36.20
Power pole NW 60.65
Telephone pole NE 62.62
Guy pole NE 48.5


B. Description of corner evidence found and/or method applied in restoring or reestablishing corner:
B-9 Found 5/8" iron in monument box.
B-9 to centerline railroad Peck = 73', meas. = 72.74 B-9 to A-9 Peck = 2798, meas. = 2797.18, meas. = 2798.48 (to old position of A-9)

Found 5/8" iron fits the monumentation of Plats; Plat of the NW 1/4, Section 19, Howard's Addition, Hyma's Supervisor's Resubdivision and many other plats and surveys. See sketch on back.

Replaced 5/8" iron with an Ottawa County Remonumentation iron and cap and accepted it as a careful and faithful perpetuation of the position of the original corner.

FILED APPROVED 9/20/99
[Signature]

C. Description of monument for corner and accessories established to perpetuate locating the position of the corner:
B-9 Ottawa County Remonumentation iron and cap in monument box.
Azimuth = Michigan State Plane grid direction
Remonumentation tag in S side power pole 294° 06' 188.21
Remonumentation tag in NW side power pole 217° 25' 43.95
Survey tag in W side power pole 19° 02' 107.37
SW corner house foundation 26° 24' 180.73
SW corner house foundation 166° 38' 173.99
Centerline railroad tracks 0° 42' 72.74

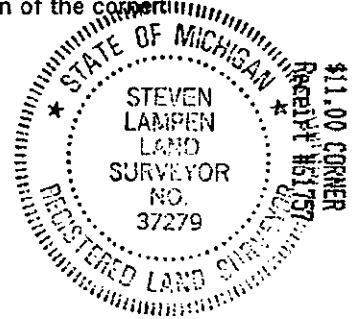

Signed by Steven Lampen Date OCTOBER 16, 1999
Surveyor's Michigan License No. 37279


FEB 24 2000

SECTION



A-9

MEAS. 2797.18 = 2798.48 OLD LOCATION OF A-9
PECK 2798

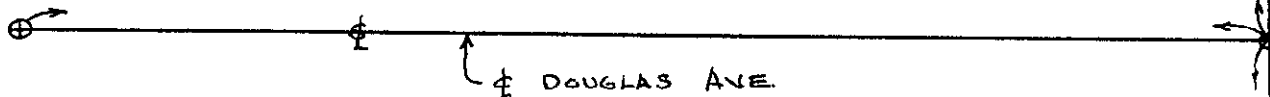

MEAS. 72.74
PECK 73'

ANILINE

MEAS. 452.39
PECK 452.8

