

FEB 24 2000

OTTAWA COUNTY REMONUMENTATION
LAND CORNER RECORDATION CERTIFICATE
Filing Requirement of Act 74, Mich. P.A. 1970

RECORDED

99 OCT 27 PM 1:49

SECTION

Ray Scholtz
REGISTER OF DEEDS
OTTAWA COUNTY MICHIGAN

For corners in Ottawa <small>(County)</small>	Located In:	Corner Code #
1. Public Land Survey	T5N R15W	B-13
	T R	
	T R	South 1/4 corner
	T R	Section 31
2. Property Controlling in Section	S T R	
	S T R	Holland Township
3. Miscellaneous Property in Sec.	S T R	

Register of Deeds Stamp & File Number

4. Lot No. _____ Recorded Plat _____
5. Private Claims _____

1	A	B	C	D	E	F	G	H	I	J	K	L	M
2	6	5	4	3	2	1							
3													
4	7	8	9	10	11	12							
5													
6	18	17	16	15	14	13							
7													
8	19	20	21	22	23	24							
9													
10	30	29	28	27	26	25							
11													
12	31	32	33	34	35	36							
13													

I, Steve Lampen, in a field survey on September 14, 1999, do hereby certify that under requirements of P.A. 74, Michigan P.A. of 1970, the corner points mentioned in lines 1 and 2 above were in conformance with regulations and rules therefore as required in the current manual of survey instructions of the United States Department of the Interior, Bureau of Land Management or by a decree of a Court of Law and/or that the corner points mentioned in lines 3, 4 and 5 above were in conformance with the rules of the Michigan Board of Land Surveyors or by a Decree of a Court of Law; established, re-established, monumented, re-monumented, recovered, found as expressed below:

NOTE: Not more than 4 corners, all in the same town and range, may be recorded on this certificate.

A. Description of original monument and accessories and/or subsequent restoration:

B-13	Peck - 1890's	LCRC - L2, P117 - Englert - 1973
GLO - Sibley - 1832	B-13 to B-11 = 5286.5	3/4" Pipe
set HMP	B-13 to B-12 = 2643	SW 37.76 power pole
Hemlock 5 N 79 E 15		NW 35.79 power pole
Hemlock 12 N 22 W 32	B-13 is shown on Plat	NE 36.12 guy pole
	of Southwest Heights - 1897	

9/20/99
SL

B. Description of corner evidence found and/or method applied in restoring or reestablishing corner:

B-13 Found 3/4" pipe in monument box
 B-13 to C-13 Peck = 2650.6 measured = 2650.99 B-13 to B-11 Peck = 5286.5 measured = 5286.61

The Found position of the corner fits the monumentation of Southwest Heights Subdivision and many other recent plats and surveys.


Replaced pipe with an Ottawa County Remonumentation iron and cap and is accepted as a careful and faithful Perpetuation of the position of the original corner.

C. Description of monument for corner and accessories established to perpetuate locating the position of the corner:

B-13 Ottawa County Remonumentation iron and cap in monument box.

Azimuth = Michigan State Plane grid direction.

NE corner house foundation	236° 22'	123.99
NE corner house foundation	324° 39'	107.54
NW corner house foundation	35° 44'	103.24
NW corner house foundation	128° 38'	112.88
B-1, T4N, R15W, remonumentation iron	270° 41'	5.07

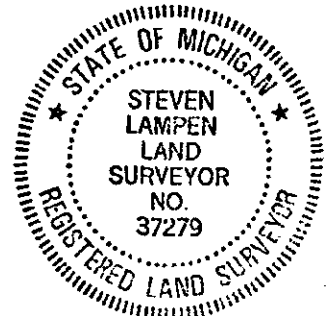

Receipt #61757

Signed by Steven Lampen

Date OCTOBER 16, 1999

Surveyor's Michigan License No. 37279