

SURVEY & REMONUMENTATION

FEB 27 1998

OTTAWA COUNTY REMONUMENTATION LAND CORNER RECORDATION CERTIFICATE Filing Requirement of Act 74, Mich. P.A. 1970

SECTION

For corners in Ottawa _____ (County)	Located In:	Corner Code #
1. Public Land Survey	T5N ___ R15W ___ T ___ R ___ T ___ R ___ T ___ R ___	C-1 NW cor. Sec. 5 Holland Twp.
2. Property Controlling in Section	S ___ T ___ R ___ S ___ T ___ R ___	_____
3. Miscellaneous Property in Sec.	S ___ T ___ R ___ S ___ T ___ R ___	_____
4. Lot No. _____	Recorded Plat _____	
5. Private Claims _____		

RECORDED

97 DEC -8 AM 11:30

Sam R. [Signature]
REGISTER OF DEEDS
OTTAWA COUNTY, MI

Register of Deeds Stamp & File Number

I, STEVE LAMPEN, in a field survey on November 17 19 97, do hereby certify that under requirements of P.A. 74, Michigan P.A. of 1970, the corner points mentioned in lines 1 and 2 above were in conformance with regulations and rules therefore as required in the current manual of survey instructions of the United States Department of the Interior, Bureau of Land Management or by a decree of a Court of Law and/or that the corner points mentioned in lines 3, 4 and 5 above were in conformance with the rules of the Michigan Board of Land Surveyors or by a Decree of a Court of Law; established, re-established, monumented, re-monumented, recovered, found as expressed below:

NOTE: Not more than 4 corners, all in the same town and range, may be recorded on this certificate.

A. Description of original monument and accessories and/or subsequent restoration:

G.L.O.
Brookfield 1832
82.83 to North boundary 98 links East of post at a Maple 10" diameter corner Section 5 and 6

L.C.R.C.
Liber 6, Page 51, 1990
Found broken cast iron monument and set cast iron monument
Olive Township corner West 62.05'
Centerline hydrant Southeast 38.50'
Nail inside guy pole North Northwest 29.58'
Power pole Northeast 66.66'

L.C.R.C.
Liber 2, Page 495, 1973
Found bent steel bar
Set cast iron monument
Olive Township West 67.05'
Guy pole North Northwest 28.91'
Hydrant Southeast 35.80'
Power pole Southeast 79.05'
Northwest corner headwall Southeast 42.25'
Southwest corner headwall Northeast 40.47'

B. Description of corner evidence found and/or method applied in restoring or reestablishing corner:

C-1
Found cast iron monument in monument box
Southwest corner Section 32 T6N R15W West 67.05'
Centerline hydrant Southeast 38.50'
Power pole Northeast 66.66'

Established corner at the intersection of the West line of Section 5 with the South line of Section 32, T6N, R15W and accepted it as a careful and faithful perpetuation of the position of the original corner.

P.A. 345 OTTAWA COUNTY

PEER APPROVED 12-1-97

[Signature]

C. Description of monument for corner and accessories established to perpetuate locating the position of the corner:


C-1
Set Ottawa County Remonumentation iron with cap in set monument box.
Established corner at intersection of the West line of Section 5 with the South line of Section 32, T6N, R15W.
AZ = Michigan State Plane grid direction

Cast iron monument in monument box	359° 43' 19"	5.15'
C-13, T6N, R15W	270° 45' 43"	66.99'
Hydrant top centerline	137° 33'	34.53'
Nail and remonumentation tag in Northwest side power pole	53° 03'	69.60'
Nail and remonumentation tag in Northeast side power pole	123° 56'	78.22'
Nail and remonumentation tag in Northwest side power pole	245° 15'	93.67'
Southeast corner garage, aluminum siding	297° 17'	185.02'
Centerline of East & West asphalt Road	0°	5.00'

Signed by Steven Lampen

Date DECEMBER 1, 1997

Surveyor's Michigan License No. 37279

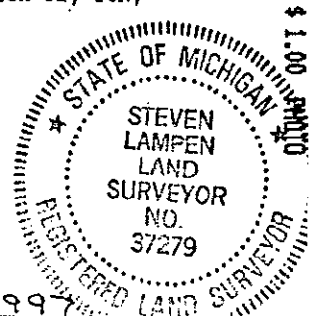

FORM APPROVED BY MICHIGAN STATE BOARD OF LAND SURVEYORS, JAN. 28, 11
REVISED MAY 14, 10
REVISED JAN., 19
ADAPTED FOR WORD PROCESSING MARCH, 19