

**SURVEY & REMONUMENTATION**

DEC 01 1998

**OTTAWA COUNTY REMONUMENTATION  
LAND CORNER RECORDATION CERTIFICATE  
Filing Requirement of Act 74, Mich. P.A. 1970**

**SECTION**  
For corners in  
OTTAWA  
(County)

Located In: Corner Code #

1. Public Land Survey	T <u>5</u> N	R <u>15</u> W	C-3 (NE cor Section 7) Holland Twp.
	T <u>   </u>	R <u>   </u>	_____
	T <u>   </u>	R <u>   </u>	_____
	T <u>   </u>	R <u>   </u>	_____
2. Property Controlling in Section	S <u>   </u>	T <u>   </u>	_____
	S <u>   </u>	T <u>   </u>	_____
3. Miscellaneous Property in Sec.	S <u>   </u>	T <u>   </u>	_____
	S <u>   </u>	T <u>   </u>	_____

RECORDED

98 MAR 16 PM 12: 37

*Randy K. Heltzer*  
REGISTER OF DEEDS  
OTTAWA COUNTY, MI

Register of Deeds Stamp & File Number

4. Lot No. \_\_\_\_\_, Recorded Plat \_\_\_\_\_  
5. Private Claims \_\_\_\_\_

I, Randal J. Vugteveen, in a field survey on August 22, 19 96 do hereby state that under requirements of P.A. 74, Michigan P.A. of 1970, the corner points mentioned in lines 1 and 2 above were in conformance with regulations and rules therefore as required in the current manual of survey instructions of the United States Department of the Interior, Bureau of Land Management or by a decree of a Court of Law and /or that the corner points mentioned in lines 3, 4 and 5 above were in conformance with the rules of the Michigan Board of Land Surveyors or by a Decree of a Court of Law; established, re-established, monumented, recovered, found as expressed below:

NOTE: Not more than 2 corners, all in the same town and range, may be recorded on this certificate.

A	B	C	D	E	F	G	H	I	J	K	L
1											
2	6		5		4		3		2		1
3		●									
4	7		8		9		10		11		12
5											
6	10		17		16		15		14		13
7											
8	19		20		21		22		23		24
9											
10	30		29		28		27		26		25
11											
12	31		32		33		34		35		36
13											

**A. Description of original monument and accessories and/or subsequent restoration:**

C-3 Common corner to Sections 5, 6, 7 & 8  
1832 - Brookfield  
Set corner  
Hemlock 10" West 8 Links  
W. Ash 12" N48°E 29 Links

LCRC Liber 2, Page 679  
Found R.R. Spike  
Power Pole NW 55.52'  
St. Sign NE 35.03'  
Hydrant SE 53.50'  
Power Pole SE 86.68'

LCRC Liber 1, Page 655  
Found R.R. Spike  
P. Pole NW 55.52'  
St. Sign NE 35.03'  
Stop Sign NE 48.13'  
Hydrant SE 53.30'  
P. Pole SE 86.68'  
Stop Sign SW 43.90'

**B. Description of corner evidence found and/or method applied in restoring or reestablishing corner:**

C-3 Found R.R. spike in bit with "X" filed in top leaning East, 1' N of centerline "X" of Quincy & 136th Ave.

Hydrant SE 53.65'  
P.Pole SE 87.10'

Accepted position of RR spike as a careful perpetuation of the position of the original corner


Removed RR spike and replaced with a 24"x3/4" solid bar with Ottawa County Remon Cap in monument box

P.A. 345 OTTAWA COUNTY  
PEER APPROVED 12/1/97

**C. Description of monument for corner and accessories established to perpetuate locating the position of the corner:**

C-3 3/4" X 24" iron bar with Ottawa County Remon cap in monument box

Set Ottawa County Remon tag & nail 3' N & 3' E AZ 297° 53.55'  
SE block foundation corner house porch #4009 AZ 311° 99.58'  
Set Ottawa County Remon tag & nail in S. side P. pole AZ 245° 92.94'  
Top centerline hydrant AZ 142° 53.65'  
Top of SW corner conc. transformer pad AZ 48° 56.44'  
Centerline North-South road West 0'  
Centerline East-West road South 1'

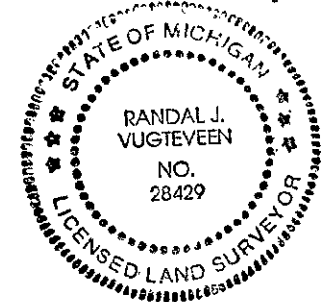

\$ 1.00 PHOTO

Signed by Randal J. Vugteveen  
Surveyor's Michigan License No. 28429

Date DEC. 1, 1997