

SURVEY & REMONUMENTATION

JUN 28 1999

OTTAWA COUNTY REMONUMENTATION

RECORDED

98 NOV 11 PM 1:26

LAND CORNER RECORDATION CERTIFICATE
Filing Requirement of Act 74, Mich. P.A. 1970

Randy Schmitt
REGISTER OF DEEDS
OTTAWA COUNTY, MI

For corners in SECTION

OTTAWA

(County)

Located In:

Corner Code #

1. Public Land Survey

T 5N R 15W

C-5 SW Cor. Sec 8

T R

Holland Twp

T R

T R

2. Property Controlling in Section

S T R

S T R

3. Miscellaneous Property in Sec.

S T R

S T R

Register of Deeds Stamp & File Number

4. Lot No. _____, Recorded Plat _____

5. Private Claims _____

I, Randal J. Vugteveen, in a field survey on October 13, 1998 do hereby state that under requirements of P.A. 74, Michigan P.A. of 1970, the corner points mentioned in lines 1 and 2 above were in conformance with regulations and rules therefore as required in the current manual of survey instructions of the United States Department of the Interior, Bureau of Land Management or by a decree of a Court of Law and /or that the corner points mentioned in lines 3, 4 and 5 above were in conformance with the rules of the Michigan Board of Land Surveyors or by a Decree of a Court of Law, established, re-established, monumented, recovered, found as expressed below:

NOTE: Not more than 2 corners, all in the same town and range, may be recorded on this certificate.

	A	B	C	D	E	F	G	H	I	J	K	L	M
1													
2	6		5		4		3		2		1		
3													
4	7		8		9		10		11		12		
5													
6	18		17		16		15		14		13		
7													
8	19		20		21		22		23		24		
9													
10	30		29		28		27		26		25		
11													
12	31		32		33		34		35		36		
13													

A. Description of original monument and accessories and/or subsequent restoration:

C-5 GLO April 1832

Brookfield

Set Corner

10" Hemlock S7°W 7 Links

16" Hemlock West 15 Links

C-5 Liber 1 Page 257 Clapp 1972

Fd Pk Nail

Nail in face PP NW 54.16'

Nail in face Tel Pole SE 44.60'

Nail in face 24" Oak 88.04'

Nail in face 16" Basswood 82.25'

Conc Monument SW 44.39'

SE edge conc curb SW 37.66'

C-5 Liber 4, Page 187

Wickham 1981

Set 5/8" Iron Pipe

NW 54.57' to Pk E Side PP

NE 61.06' to centerline top Hyd

SE 45.08' Pk SW side PP

SW 41.65' Pk SE side PP

(Continue on back)

B. Description of corner evidence found and/or method applied in restoring or reestablishing corner:

Find 3/4" X 24" with O.C. Remon Cap Steel Bar in Monument Box

Check center top of hydrant N34°E 61.17'

Centerline Riley Street South 3.5'

Centerline 136th Ave West 1'

Accepted 3/4" X 24" Steel Bar with Remon Cap in Mon Box as a careful and faithful perpetuation of the original corner.

RA 345 OTTAWA COUNTY
PEER APPROVED 10/19/98
[Signature]

C. Description of monument for corner and accessories established to perpetuate locating the position of the corner:

C-5 3/4" X 16" or 24" bar and Remon Cap in monument box, 3.5'N and 1' E of "X"

Found Ottawa Co Remon Tag and Nail in NW side Crosswalk Pole N41°E 63.80'

Found Ottawa Co Remon Tag and Nail in NW side Crosswalk Pole S52°W 63.89'

Found Ottawa Co Remon Tag and Nail in NE side light pole Az S36°E 62.72'

Found Ottawa Co. Remon Tag and Nail in SW side Light Pole Az 314° 62.05'

Centerline top of hydrant N34°E 61.17'


NE Corner Block fndn garage #230 S44°W 111.04'

NE Corner Grace Reformed Church S50°E 187.27'

Signed by *Randal J. Vugteveen*

Surveyor's Michigan License No. 28429

Date OCTOBER 19, 1998

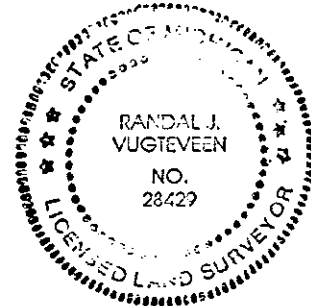

\$11.00 CORNER
Receipt #19293

\$2.00 PHOTO
Receipt #19293

C-5 Liber 5, Page 116
Englert 1984
Set Cast Iron Mon
PP NW 54.48'
Conc. Mon SW 44.45'
PP SE 47.93'
Hyd NE 61.10'

C-5 Liber 6 Page 224
Brinthall 1992
Fnd Broken Cast Iron Mon
Fnd PK E side PP N30°W 54.50'
Set PK W side 24" Maple N25°E 77.75'
Set PK Top Center guard Post N68°E 42.85'
Set Chiseled "X" on E side Sign Post S30°E 50.79'
Set PK NW side PP S60°W 41.65'

In 1996 Nederveld found PK nail 3.5' North and 1' East of Centerline "X" Riley and 136th.

SURVEY &
REMONUMENTATION

JUN 28 1999

SECTION