

SURVEY & REMONUMENTATION

APR 25 1995

COMMISSION

OTTAWA COUNTY REMONUMENTATION

LAND CORNER RECORDATION CERTIFICATE
Filing Requirement of Act 74, Mich. P.A. 1970

RECORDED

94 DEC -8 PM 12:33

Dorothy M. Robinson
REGISTER OF DEEDS
OTTAWA COUNTY, MI

For corners in OTTAWA
(County)

Located In: Corner Code #

1. Public Land Survey	T <u>5N</u> R <u>15W</u>	C-6 (E 1/4 cor of Section 18) Holland Twp
	T _____ R _____	_____
	T _____ R _____	_____
	T _____ R _____	_____
2. Property Controlling in Section	S _____ T _____ R _____	_____
	S _____ T _____ R _____	_____
3. Miscellaneous Property in Sec.	S _____ T _____ R _____	_____
	S _____ T _____ R _____	_____

Register of Deeds Stamp & File Number

4. Lot No. _____, Recorded Plat _____
5. Private Claims _____

A	B	C	D	E	F	G	H	I	J	K	L	M
2	6	5	4	3	2							
3												
4	7	8	9	10	11	12						
5												
6	18	17	16	15	14	13						
7												
8	19	20	21	22	23	24						
9												
10	30	29	28	27	26	25						
11												
12	31	32	33	34	35	36						
13												

I, Randal J. Vugteveen, in a field survey on November 14, 1994, do hereby certify that under requirements of P.A. 74, Michigan P.A. of 1970, the corner points mentioned in lines 1 and 2 above were in conformance with regulations and rules therefore as required in the current manual of survey instructions of the United States Department of the Interior, Bureau of Land Management or by a decree of a Court of Law and/or that the corner points mentioned in lines 3, 4 and 5 above were in conformance with the rules of the Michigan Board of Land Surveyors or by a Decree of a Court of Law; established, re-established, monumented, re-monumented, recovered, found as expressed below:

NOTE: Not more than 4 corners, all in the same town and range, may be recorded on this certificate.

A. Description of original monument and accessories and/or subsequent restoration:

C-6 common corner to Sections 17 & 18	Liber 1, Page 257	Liber 4, Page 177
1832 - Brookfield	Fnd PK Nail	3/4" Iron Pipe / NW 53.50' to nail & cap
Set post	Tel Pole NNE 101.75' / Centerline 30" Elm	in S side of 18" Cherry / NE 40.18' to PK
Beech 10" N85E 45 Links	NE 35.2' / NE cor house SW 93.13' / SE	nail in NW side guy pole / SE 35.21' to
Locus 10" N80W 9 Links	corner house W 63.45' / NE corner house NW	nail & cap in NE side guy pole / SW 35.66'
	60.95' / R R spike on line S 122.65'	to nail & cap in SE side of power pole


B. Description of corner evidence found and/or method applied in restoring or reestablishing corner:
C-6 Found broken CIM at centerline "X" of 136th & Felch and accepted as a careful and faithful perpetuation of the position of the original corner

CIM	NE 40.21' to PK nail in NW side guy pole /	NE corner house SW 93.13'
Nail in N side 24" Sassafrass 58.69' East	S44E 35.17' to nail & cap #16042 in NE	SE corner house W 63.45'
Hydrant NW 61.79'	side guy pole / S43W 35.73' to nail & cap	NE corner house NW 60.95'
	in SE side of power pole	RR spike on line S 122.65'

P.A. 345 OTTAWA COUNTY
PEER APPROVED 11/21/94
Robert D. Nedersold

C. Description of monument for corner and accessories established to perpetuate locating the position of the corner:
C-6 Cast Iron Monument in Mon Box

Set Ottawa County Remon Tag & Nail in Guy pole N38E 40.29'
NW foundation corner house #715 S71E 88.62'
NE corner brick house #714 S51W 118.30'
Set Ottawa County Remon Tag & Nail NW side P. ple S45W 35.70'
Top hydrant N67W 61.75'

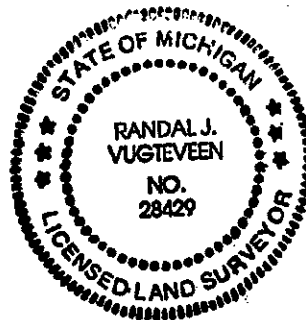

Signed by *Randal J. Vugteveen* Date Nov. 21, 1994
Surveyor's Michigan License No. 28429