

SURVEY & REMONUMENTATION

APR 24 1995

OTTAWA COUNTY REMONUMENTATION

RECORDED

LAND CORNER RECORDATION CERTIFICATE
Filing Requirement of Act 74, Mich. P.A. 1970

94 DEC 14 AM 9:43

COMMISSION
For corners in
OTTAWA
(County)

Ralphie Karlsson
REGISTER OF DEEDS
OTTAWA COUNTY, MI

	Located In:	Corner Code #
1. Public Land Survey	<u>5N</u> <u>15W</u>	<u>C-8 (E 1/4 cor Section 19)</u> <u>Holland Twp.</u>
	T _____ R _____	
	T _____ R _____	
	T _____ R _____	
2. Property Controlling in Section	S _____ T _____ R _____	
	S _____ T _____ R _____	
3. Miscellaneous Property in Sec.	S _____ T _____ R _____	
	S _____ T _____ R _____	
4. Lot No. _____, Recorded Plat _____		
5. Private Claims _____		

Register of Deeds Stamp & File Number

I, Randal J. Vugteveen, in a field survey on December 8, 19 94, do hereby certify that under requirements of P.A. 74, Michigan P.A. of 1970, the corner points mentioned in lines 1 and 2 above were in conformance with regulations and rules therefore as required in the current manual of survey instructions of the United States Department of the Interior, Bureau of Land Management or by a decree of a Court of Law and/or that the corner points mentioned in lines 3, 4 and 5 above were in conformance with the rules of the Michigan Board of Land Surveyors or by a Decree of a Court of Law; established, re-established, monumented, re-monumented, recovered, found as expressed below:

	A	B	C	D	E	F	G	H	I	J	K	L	M
2	6	5	4	3	2	1							
3													
4	7	8	9	10	11	12							
5													
6	18	17	16	15	14	13							
7													
8	19	20	21	22	23	24							
9													
10	30	29	28	27	26	25							
11													
12	31	32	33	34	35	36							
13													

NOTE: Not more than 4 corners, all in the same town and range, may be recorded on this certificate.

A. Description of original monument and accessories and/or subsequent restoration:

C-8 Common corner to Sections 19 & 20

1832 - Brookfield

Set post

Maple 18" S15W 46 Links

Maple 12" N62E 68 Links

Liber 2, Page 175

PK nail

Iron N 33.85'

20" Oak N 25.90'

32" Maple NW 63.27'

2' high solid iron 33' S & 33' W

Guy pole SW 36.65'

12" Oak SE 79.0'

Liber 6, Page 183

E 1/4 cor Section 19-5-15 Set CIM

28" Maple NW 82.36'

32" Oak SSE 75.54'

Steel post NE 63.05'

PK power pole N 26.10'

B. Description of corner evidence found and/or method applied in restoring or reestablishing corner:

C-8 Found CIM in mon box on centerline Lakewood Blvd 710' West of centerline River Ave. and accepted as a careful and faithful perpetuation of the position of the original corner

32" Oak SSE 75.45'

PK P. pole N 26.09'

P.A. 345 OTTAWA COUNTY
PEER APPROVED 12/12/94

Randal J. Vugteveen

C. Description of monument for corner and accessories established to perpetuate locating the position of the corner:

C-8 Cast Iron Monument in mon box


AZ = Michigan State Grid Direction

Set Ottawa County Remon Tag & Nail in SW side 30" Maple AZ. 315 deg 82.81'

Set Ottawa County Remon Tag & Nail in W side 30" Ash AZ. 357 deg 46.80'

Set Ottawa County Remon Tag & Nail in E side 36" Oak AZ. 165 deg 75.45'

Set Ottawa County Remon Tag & Nail in SE side 30" Oak AZ. 209 deg 93.99'

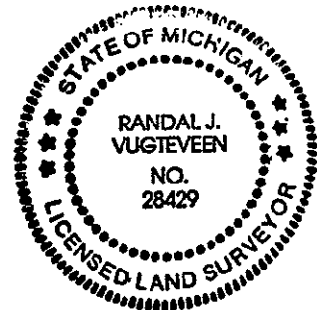

Signed by Randal J. Vugteveen
Surveyor's Michigan License No. 28429

Date Nov 12, 1994