

**OTTAWA COUNTY REMONUMENTATION
LAND CORNER RECORDATION CERTIFICATE**
Filing Requirement of Act 74, Mich. P.A. 1970

RECORDED
96 DEC 18 PM 4:57

Deputy Clerk
**REGISTER OF DEEDS
OTTAWA COUNTY, MI**

For corners in
Ottawa Located In: Corner Code #
(County)

1. Public Land Survey T5N R15W C-9
T R SE cor. Sec. 19
T R Holland Twp.
T R

2. Property Controlling S19 T5N R15W
in Section S T R

3. Miscellaneous S T R
Property in Sec. S T R

4. Lot No. _____, Recorded Plat _____

5. Private Claims _____

Register of Deeds Stamp & File Number

I, Steven Lampen, in a field survey on December 6, 1996 do hereby certify that under requirements of P.A. 74, Michigan P.A. of 1970, the corner points mentioned in lines 1 and 2 above were in conformance with regulations and rules therefore as required in the current manual of survey instructions of the United States Department of the Interior, Bureau of Land Management or by a decree of a Court of Law and/or that the corner points mentioned in lines 3, 4 and 5 above were in conformance with the rules of the Michigan Board of Land Surveyors or by a Decree of a Court of Law; established, re-established, monumented, re-monumented, recovered, found as expressed below:

NOTE: Not more than 4 corners, all in the same town and range, may be recorded on this certificate.

A. Description of original monument and accessories and/or subsequent restoration:

C-9
GLO - Brookfield - 1832
Left lake and set M. post and corner to Sec. 19, 20, 29 and 30
Tamarack 12 N 5 W 3.90'
do 10 S 4 E 3.39'

C-9 is shown on the Plat of Howard's Addition - 1872, but is not related to any of the lot lines with dimensions.

Survey by E. H. Peck - 1900 shows stone and stake for C-9, C-9 to B-9 = 2645', C-9 to C-8 = 2650'

B. Description of corner evidence found and/or method applied in restoring or reestablishing corner:


C-9
Corner now lies under a building at the Parke Davis complex. No section line occupation exists. Found no survey records indicating that C-9 had been located since the Peck Survey in 1900.

Calculated the position of C-9 using the distances by Peck in 1900, 2645' to B-9 and 2650' to C-8. Set Ottawa County Remonumentation iron and cap in (set) monument boxes as reference monuments at the intersection of the centerline of Howard Avenue with the South and East lines of Section 19. See sketch on back.

Calculated position of C-9 is accepted as a careful and faithful re-establishment of the position of original corner.

P.A. 345 OTTAWA COUNTY
PEER APPROVED 12-9-96

M.P.N.

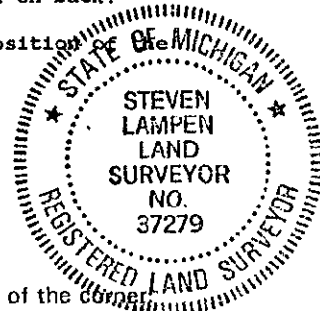

C. Description of monument for corner and accessories established to perpetuate locating the position of the original corner.

C-9 see sketch on back. Azimuths = Michigan State Plane grid direction			Reference monument - Ottawa County Remonumentation iron and cap at the intersection of the East line of Section 19 with the centerline of Howard Avenue
Reference monument - Ottawa County Remonumentation iron and cap at the intersection of the South line of section 19 with the centerline of Howard Ave.			
S'yly corner house #301, brick	325° 33'	65.62'	Remon. tag in SE side 12" Maple
E'yly corner porch, concrete block	32° 06'	124.62'	Remon. tag in N side power pole
Northerly corner house foundation	101° 49'	76.76'	Remon. tag in W side 8" Oak
Remon. tag W'yly side power pole	207° 27'	42.88'	Remon. tag in N side 10" Maple
C-9 = calculated position	90° 33' 10"	1113.42'	C-9 = calculated position
B-9 = iron in monument box	270° 33' 10"	1531.58'	C-8 = Remon. iron in monu. box

Signed by Steven Lampen Date _____

Surveyor's Michigan License No. 37279

